


T.27S., R.3W., W.M.

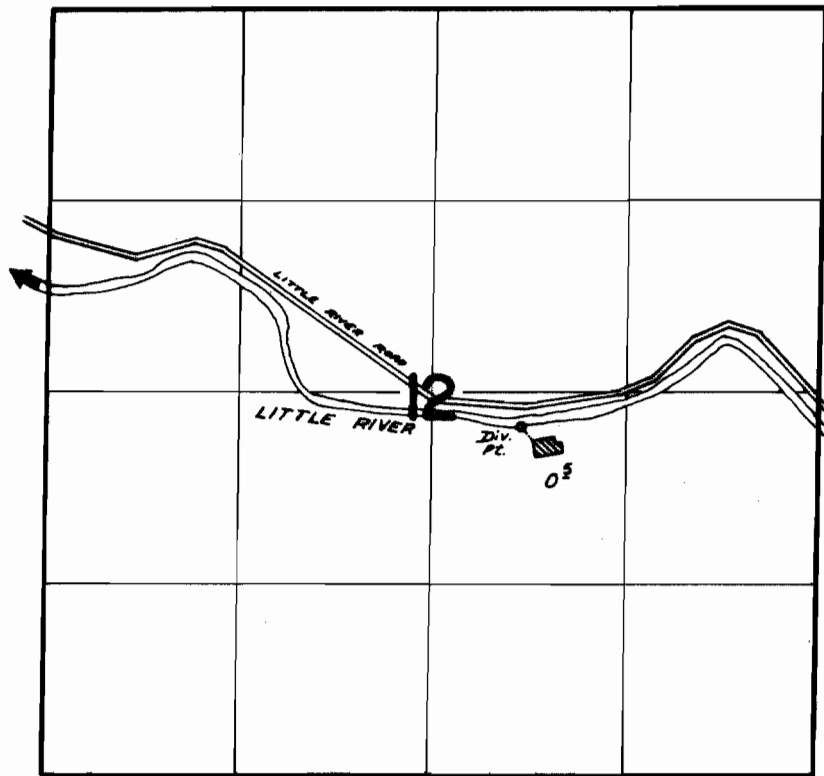

DIV. PT. LOC: 240' S & 2030' W FROM E 1/4 COR. SEC. 12

**FINAL PROOF SURVEY**  
UNDER

Application No. 51180..... Permit No. 37711.....  
IN NAME OF

EDGAR D. AND VIRGINIA M. WIGGINS

Surveyed NOV. 5... 1975., by D. NORBY.....