
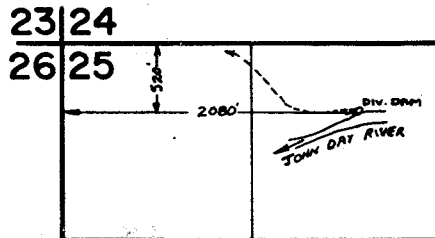


M-34703
43050

T.13S., R.30E., W.M.

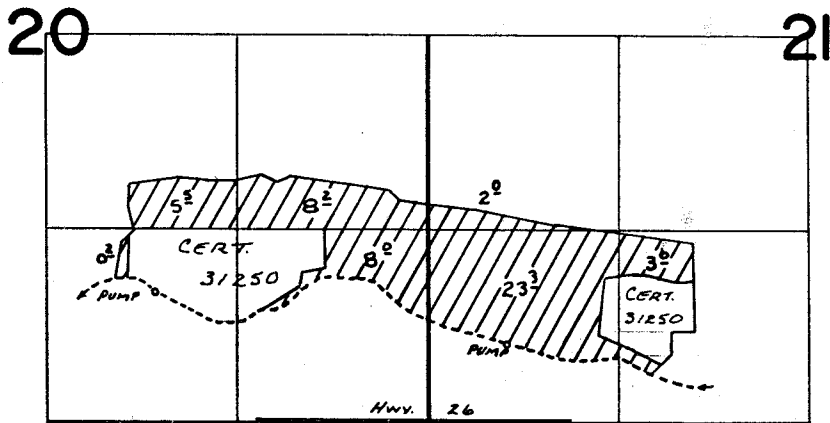

FINAL PROOF SURVEY UNDER

Application No. ~~46445~~ Permit No. ~~34703~~
IN NAME OF

PIERRE & ELIZABETH JONES

Surveyed Aug. 22, 1975, by L. Toll