


T.38S.,R.1W.,W.M.

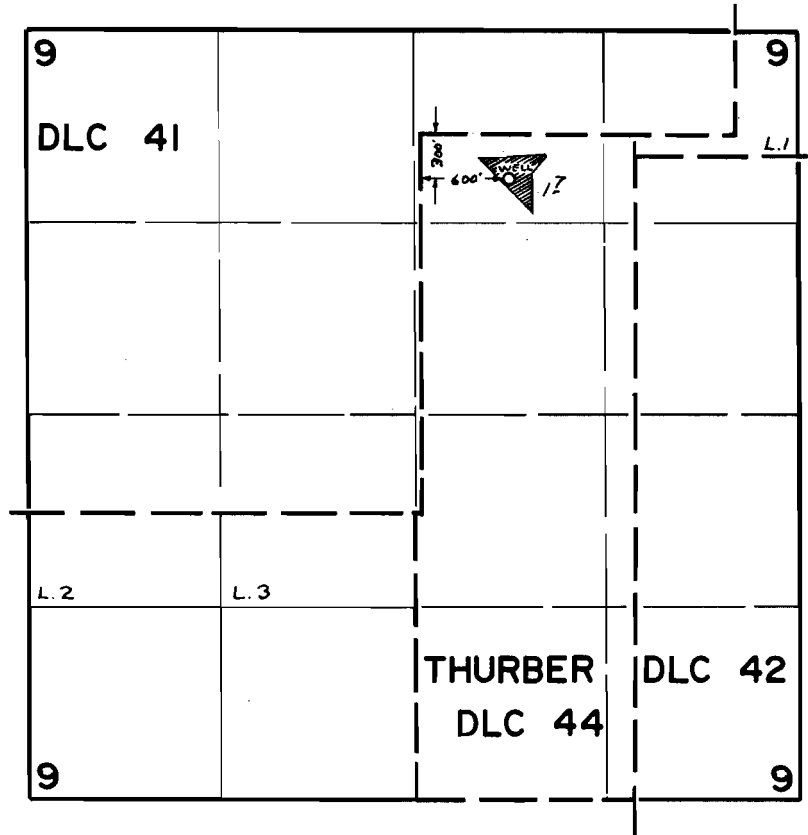

FINAL PROOF SURVEY UNDER

Application No. G-4760 Permit No. G-4484
IN NAME OF

ROYAL OAKS MOBIL MANOR

Surveyed July 10 1974, by L. Tolh