


# T.39S.,R.5W.,W.M.

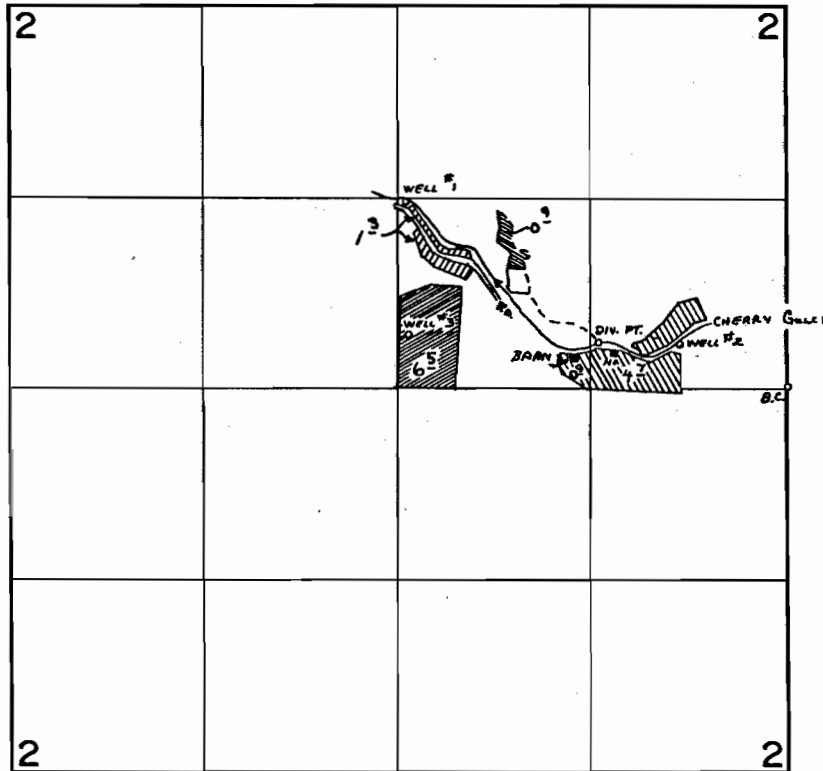

- |  |   |   |   |
|--|---|---|---|
|  | WELL #1 (PRIMARY)- 1260' N AND 2610' W          | } | FROM E <sup>1</sup> / <sub>4</sub> COR<br>OF SEC. 2 |
|  | WELL #2 (SUPPLEMENTAL)- 290' N AND 730' W       |   |   |
|  | WELL #3 (SUPPLEMENTAL)- 360' N AND 2600' W      |   |   |
|  | CHERRY GULCH DIV. (PRIMARY)- 300' N AND 1290' W |   |   |

## FINAL PROOF SURVEY UNDER

Application No. 43297 G-3302 Permit No. 32377 G-3077  
IN NAME OF

.....CLAIRE O. BROWN.....

Surveyed SEPT. 13. 1974, by L. TOLL.....