


T.38S.,R.5W.,W.M.

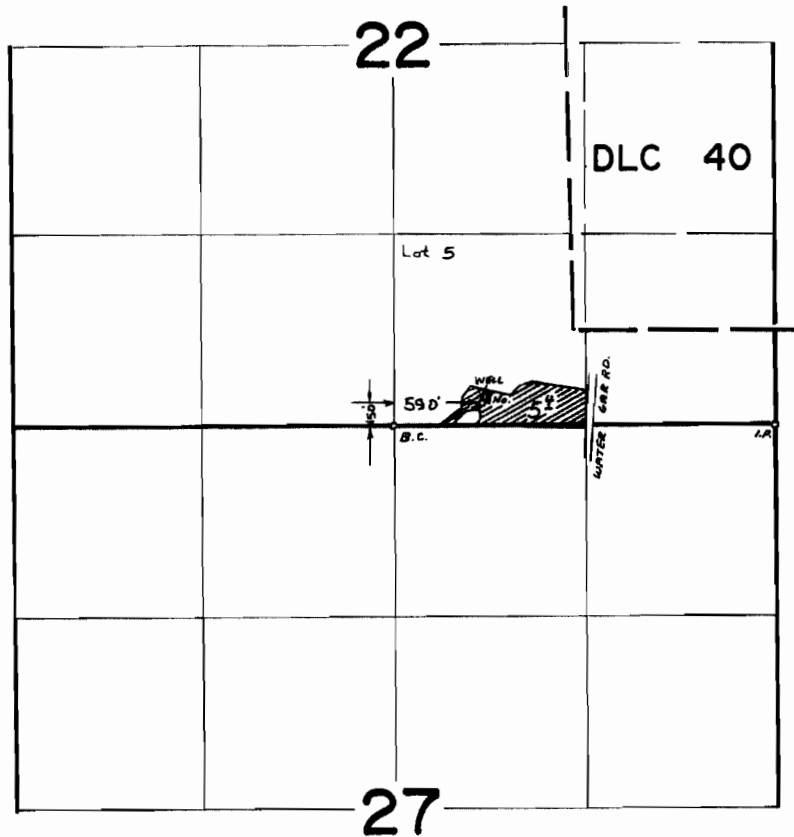

FINAL PROOF SURVEY
UNDER

Application No. G-5022 Permit No. G-4730
IN NAME OF

AZEL L. AND LORA M. BLODGETT

Surveyed OCT. 4 1974, by L. T. Tolh