


T.38S.,R.5W.,W.M.

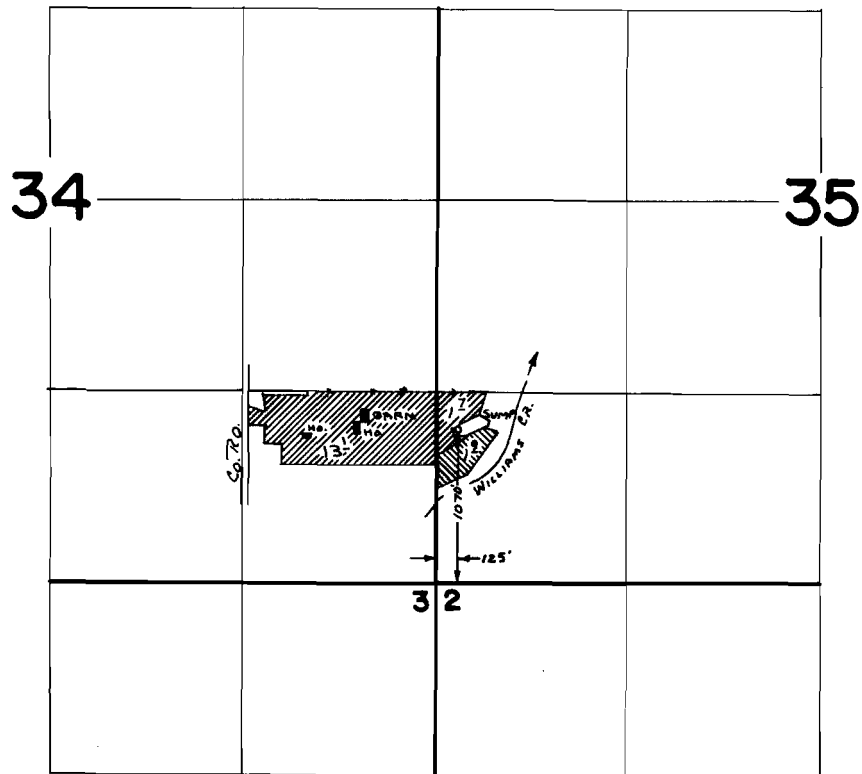

PRIMARY IRRIGATION
SUPPLEMENTAL IRRIGATION

FINAL PROOF SURVEY UNDER

Application No. G-5161 Permit No. G-4893
IN NAME OF

CLEO B. REEL

Surveyed SEPT. 19 1974, by L. TOLL