






T.39S.,R.5W.,W.M.

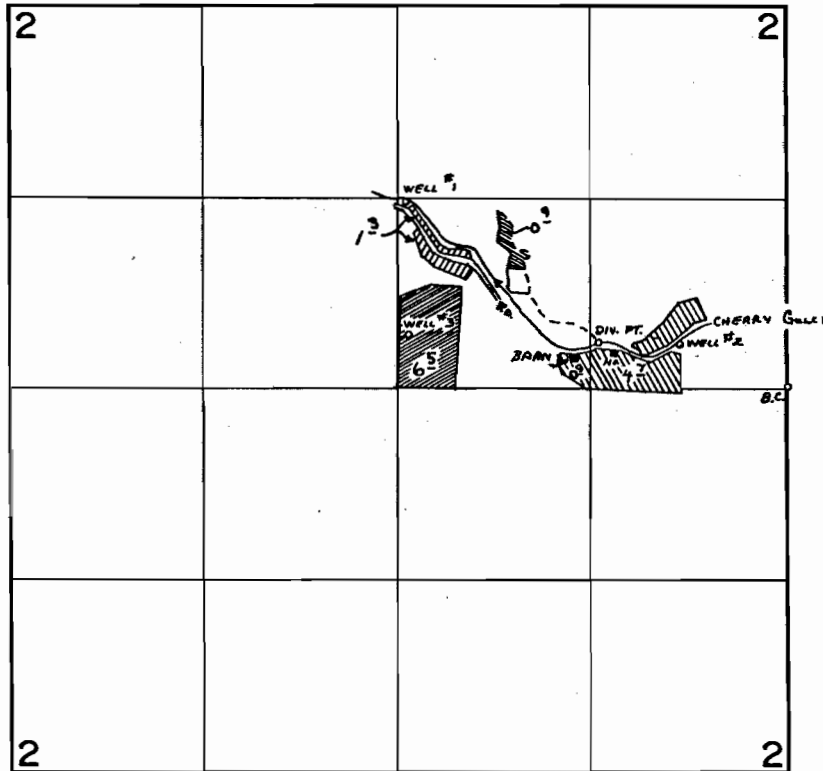

 WELL #1 (PRIMARY)- 1260' N AND 2610' W
 WELL #2 (SUPPLEMENTAL)- 290' N AND 730' W
 WELL #3 (SUPPLEMENTAL)- 360' N AND 2600' W
 CHERRY GULCH DIV. (PRIMARY)- 300' N AND 1290' W

} FROM E¹/₄ COR OF SEC. 2

FINAL PROOF SURVEY UNDER

Application No. 43297 G-3302 Permit No. 32377 G-3077
 IN NAME OF

.....CLAIRE O. BROWN.....

Surveyed SEPT. 13. 1974, by L. TOLL.....