


T.37S.,R.5W.,W.M.

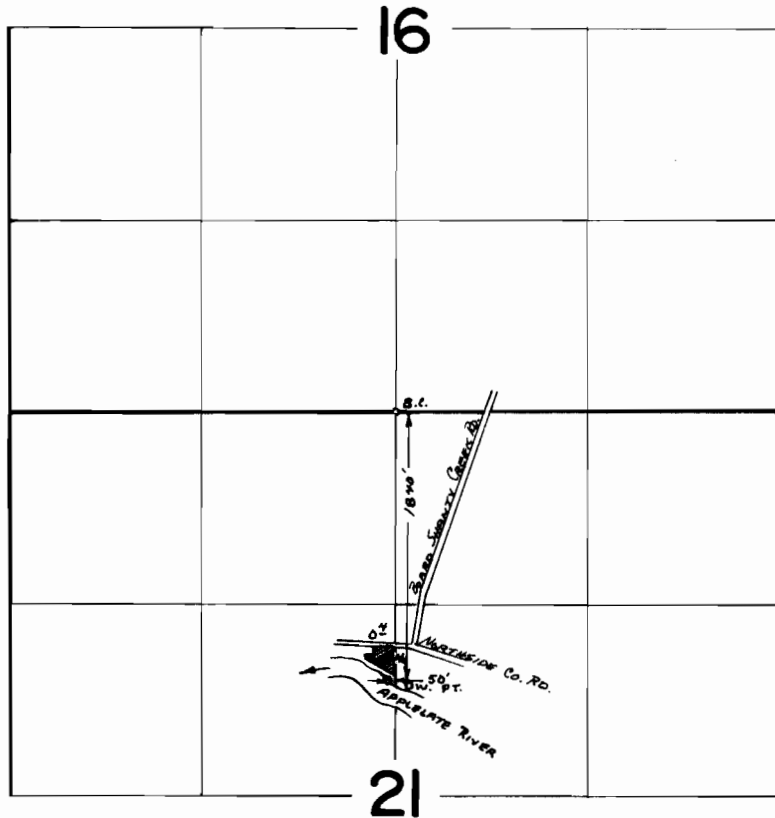

FINAL PROOF SURVEY
UNDER

Application No. 45147 Permit No. 33730
IN NAME OF

WAYNE G. HAW

Surveyed Oct. 3 1974, by L. Toll