


T.36 S. R.5 W. W.M.

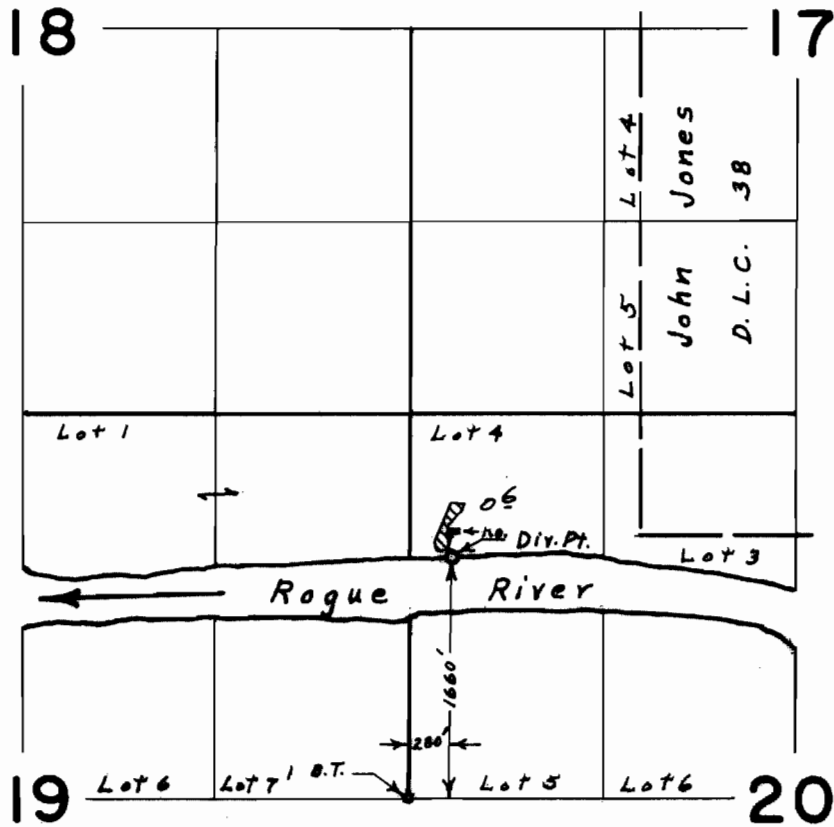

FINAL PROOF SURVEY
UNDER

Application No. 47362 Permit No. 35476
IN NAME OF

JOHN NYLUND

Surveyed April 23, 1974, by L. E. Gould