


T.36 S. R.6 W. W.M.

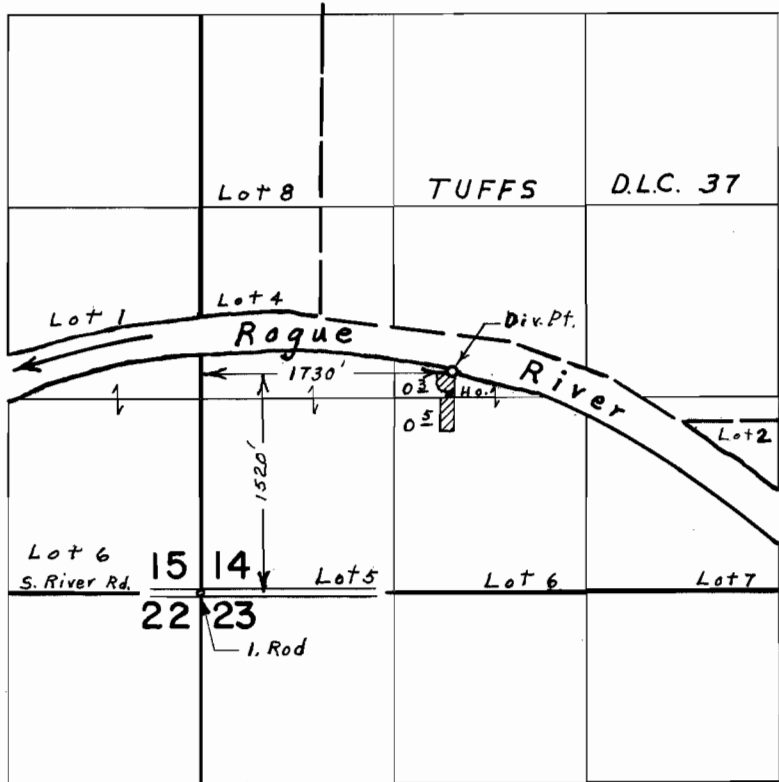

FINAL PROOF SURVEY
UNDER

Application No. 47248 Permit No. 35861
IN NAME OF

SYLVESTER & IMOGENE OSBORNE

Surveyed April 25, 1974, by L. E. Gould