


T.13S.,R.10W.,W.M.

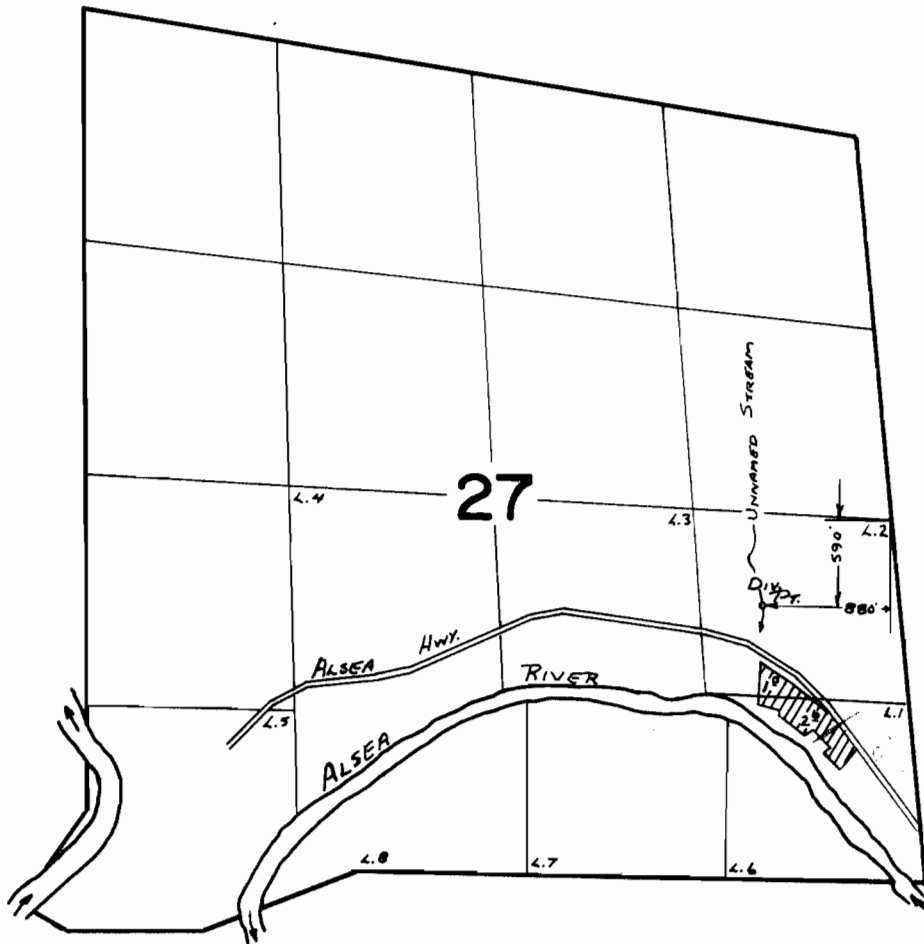

**FINAL PROOF SURVEY**  
UNDER

Application No. 38818 Permit No. 29086  
IN NAME OF

MR. & MRS. GUY COX

Surveyed Aug. 22 1974, by D. NORBY