


T.I.S.R.IOW.W.M.

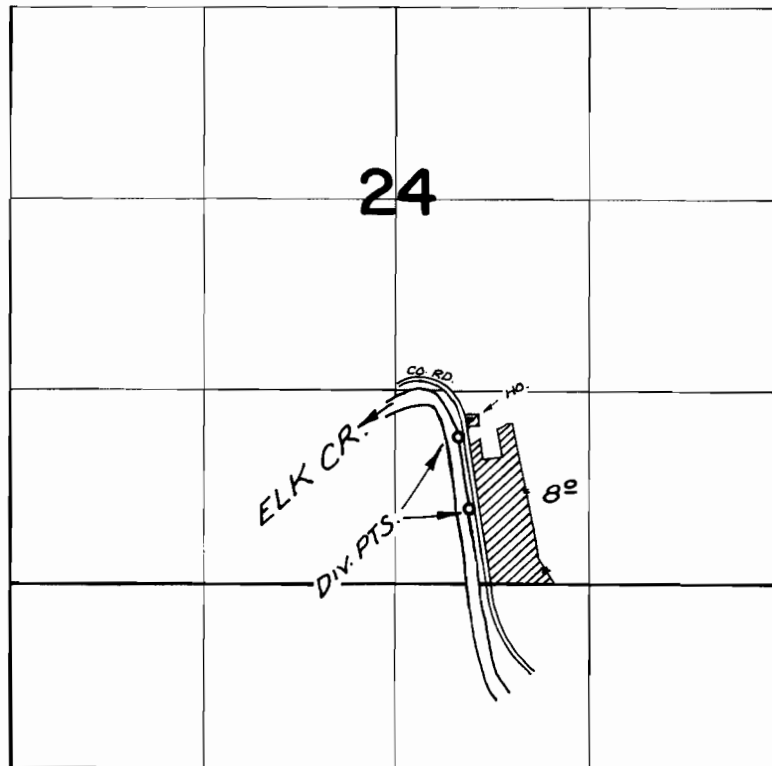

DIV. PTS. LOC: 520' N. & 520' E.; 1000' N. & 430' E., BOTH FROM
S.W. COR. SW $\frac{1}{4}$ SE $\frac{1}{4}$ SEC. 24

FINAL PROOF SURVEY
UNDER

Application No. 43126 Permit No. 32222
IN NAME OF

THE ESTATE OF WALTER N. PARKS

Surveyed AUG. 28 1974, by R. MUCKEN