


T.11S.R.9&10W.W.M.

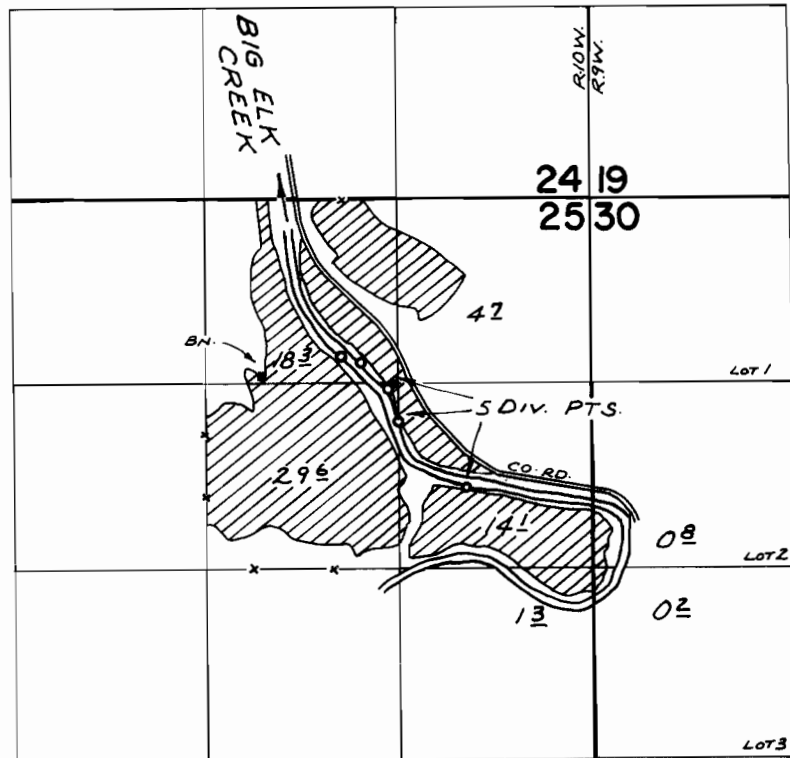

DIV. PTS. LOC: 1460'N. & 930'E.; 1420'N. & 1060'E.; 1000'N. & 1320'E.;
1230'N. & 1230'E.; 550'N. & 1770'E., ALL FROM CEN. SEC. 25

FINAL PROOF SURVEY
UNDER

Application No. 43127 Permit No. 32223
IN NAME OF

RALPH J. GILSTRAP

Surveyed AUG. 28, 1974, by R. MUCKEN