


T.8S., R.10 W., W.M.

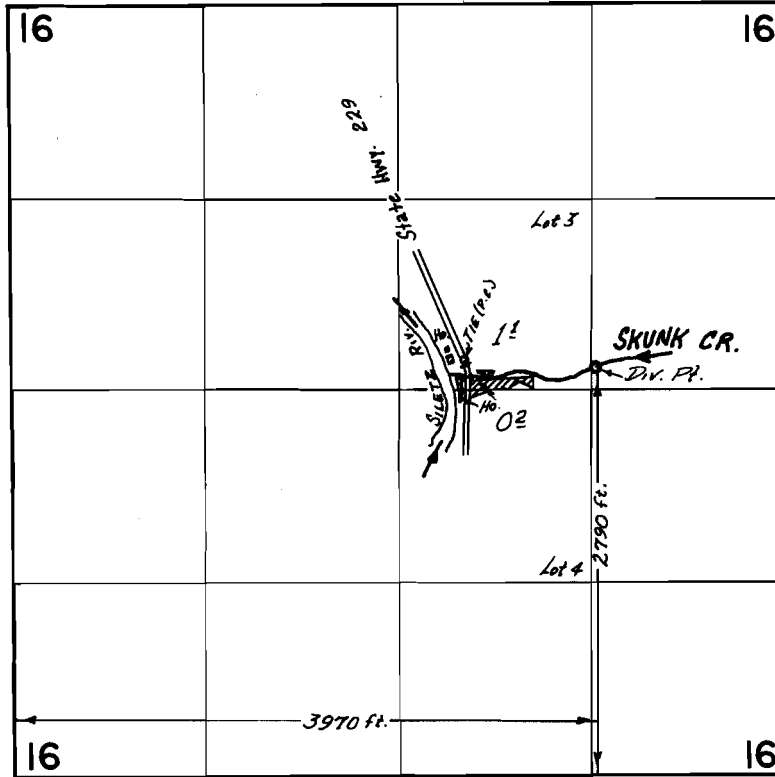

FINAL PROOF SURVEY
UNDER

Application No. 43846 Permit No. 32423
IN NAME OF

VERNON R. STEELE

Surveyed 21 Aug. 1972 by D. NORBY
19 JULY 1974 D. NORBY