


T.13S. R.11W. W.M.

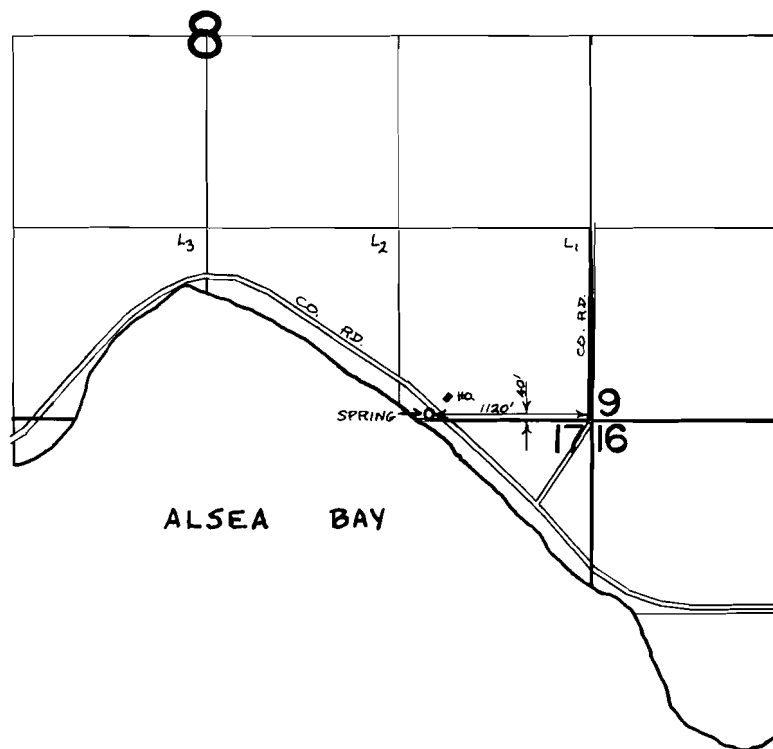

FINAL PROOF SURVEY
UNDER

Application No. 46248 Permit No. 34553
IN NAME OF

RUSSELL J. HALLOWELL

Surveyed AUG. 20 1974, by D. NORBY