


T.14S. R.11W. W.M.

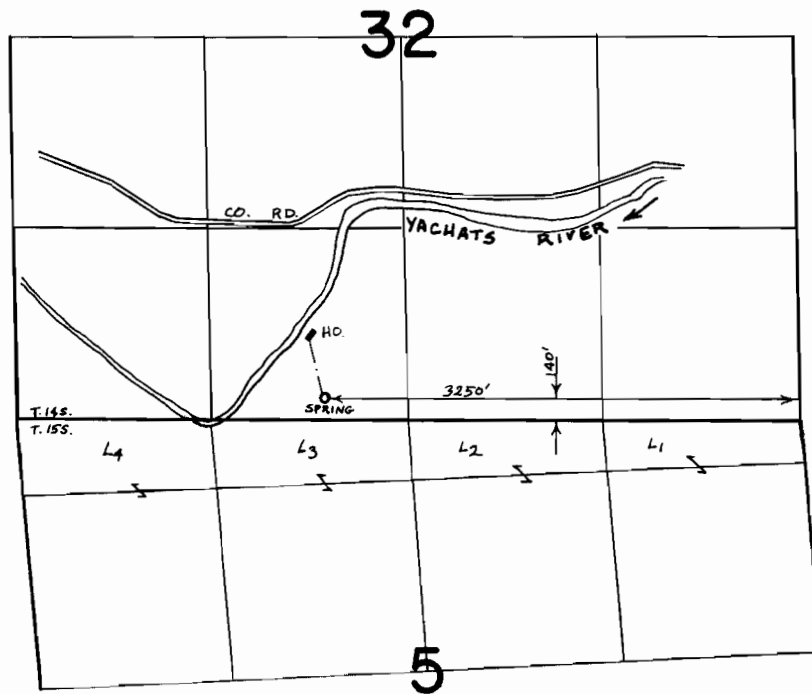

FINAL PROOF SURVEY
UNDER

Application No. 48894 Permit No. 35521
IN NAME OF

EDGAR H. & FRANCES S. FOGG

Surveyed AUG. 22 1974, by D. NORBY