


T.12S. R.11W. W.M.

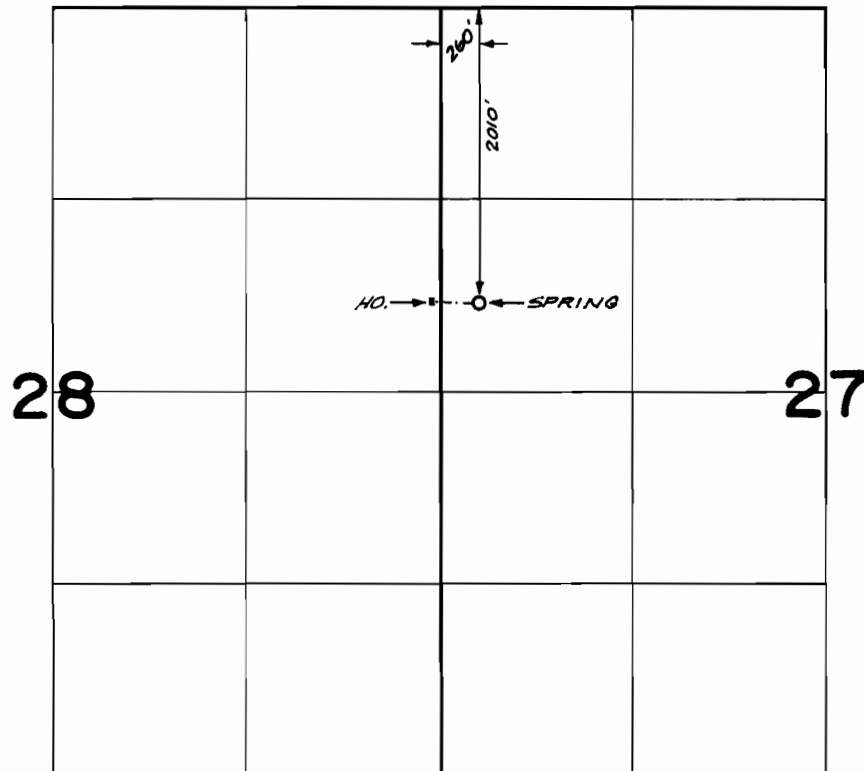

FINAL PROOF SURVEY
UNDER

Application No. 47980 Permit No. 35990
IN NAME OF

ROBERT G. ALBORN

Surveyed AUG. 21. 1974, by D. NORBY