


T.13S. R.11W. W.M.

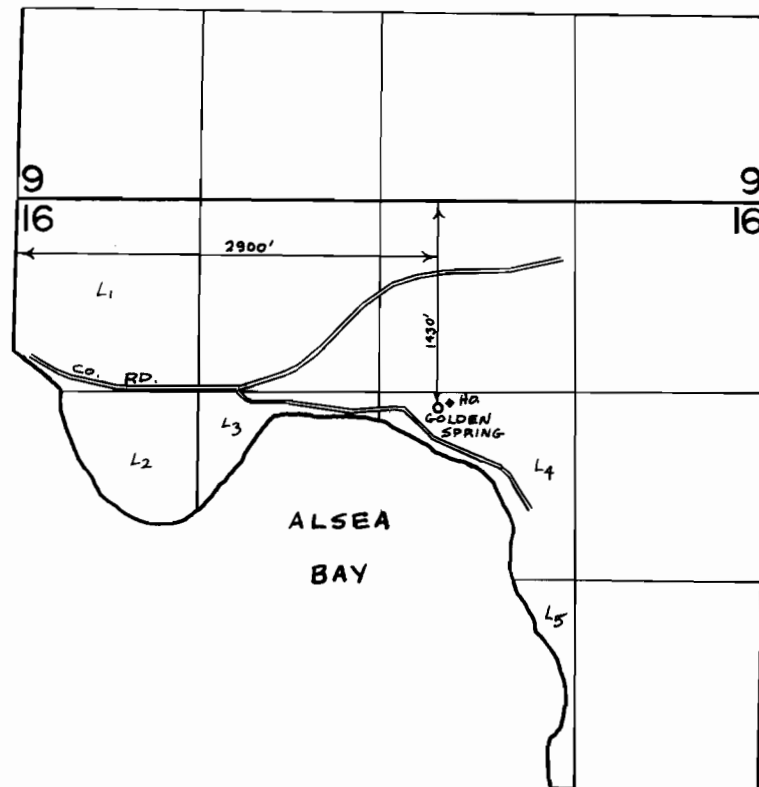

FINAL PROOF SURVEY
UNDER

Application No. 48797 Permit No. 36502
IN NAME OF

K. E. & CHARLOTTE M. GOLDEN

Surveyed AUG. 20 1974, by D. NORBY