


T.17S. R.44E. W.M.

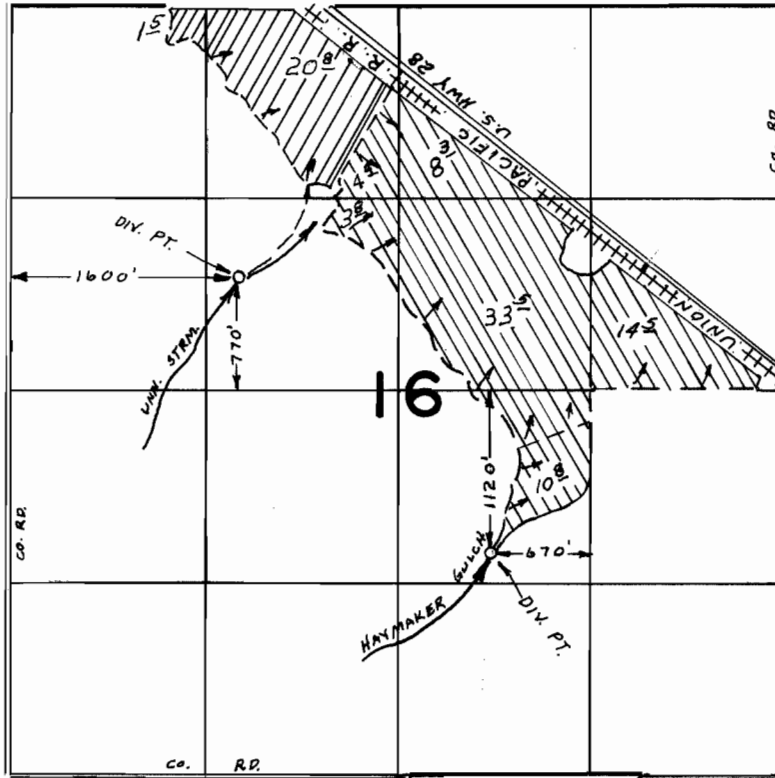

SOURCE: UNNAMED STREAM /////
 HAYMAKER GULCH /////

FINAL PROOF SURVEY UNDER

Application No. 37 08 9 3 3 2 3 0
 37 09 0 3 3 2 3 1
 IN NAME OF

JIM JOE AND NORMA CULBERTSON

Surveyed JUN 27 1974, by L. H. NUNN