


T.19S.R.1W.W.M.

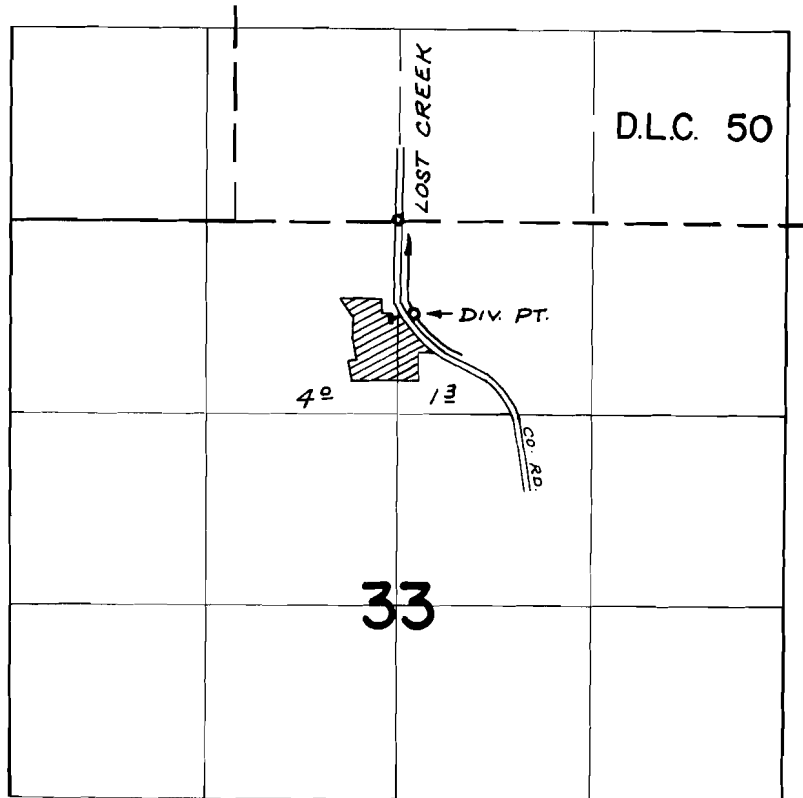

DIV. PT. LOC: 630' S. & 100' E. FROM N $\frac{1}{4}$ COR. SEC. 33

FINAL PROOF SURVEY
UNDER

Application No. 45150 Permit No. 33732
IN NAME OF

CHARLES R. BAGENT

Surveyed MAY 8, 1974, by R. MUCKEN