


T. 8S. R. 1E. W. 1M.

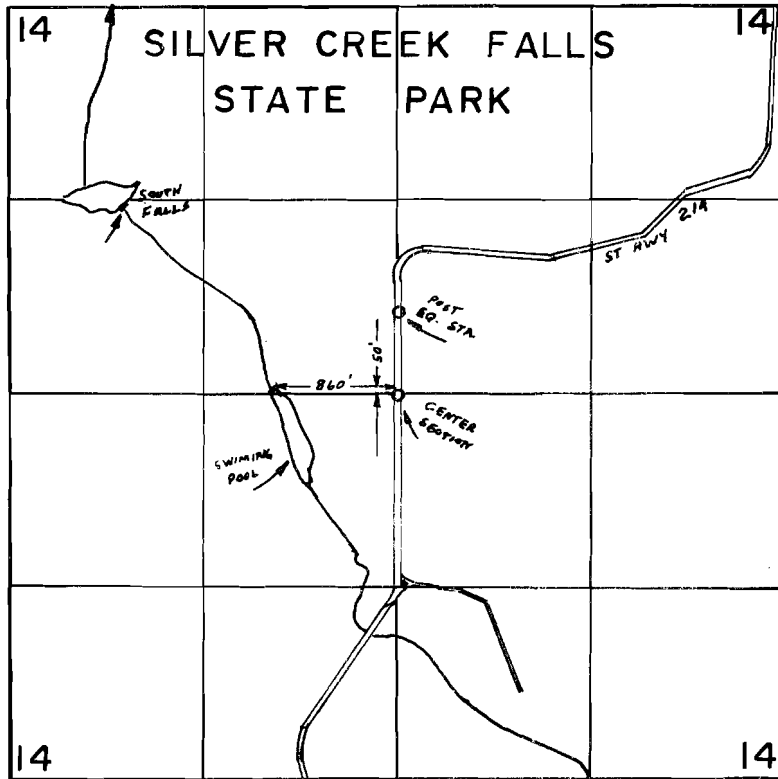

FINAL PROOF SURVEY UNDER

49688 36089
Application No. R-49505 Permit No. R-5842

IN NAME OF
OREGON STATE
PARKS & RECREATION
SECTION
Surveyed MAY 30, 1974, by L. H. NUNN