


# T. 8S. R. 1E. W. 1M.

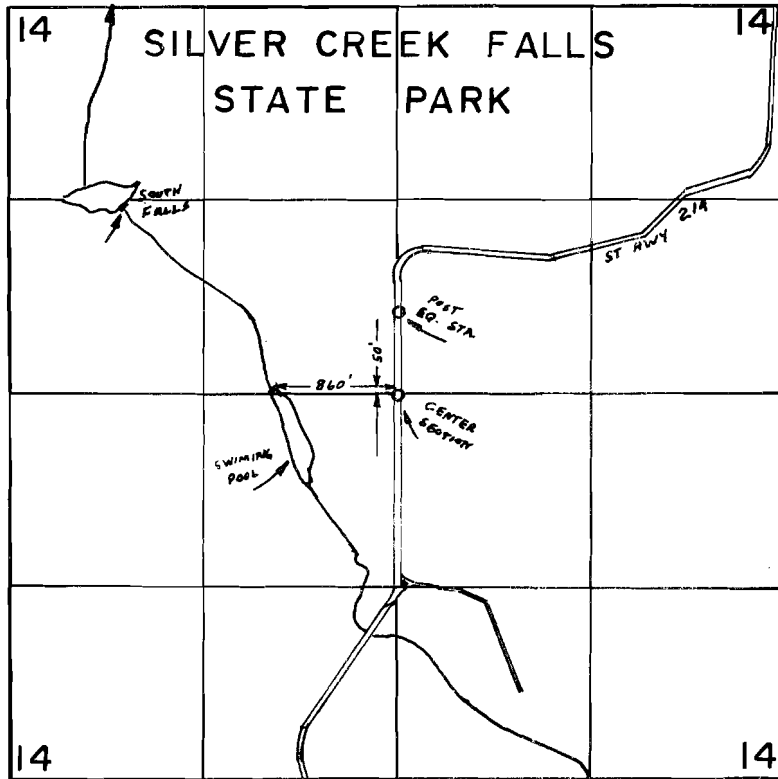

## FINAL PROOF SURVEY UNDER

49688                      36089  
Application No. R-49505    Permit No. R-5842

IN NAME OF  
OREGON STATE  
PARKS & RECREATION  
SECTION  
Surveyed MAY 30, 1974, by L. H. NUNN