


T.6S. R.6W. W.M.

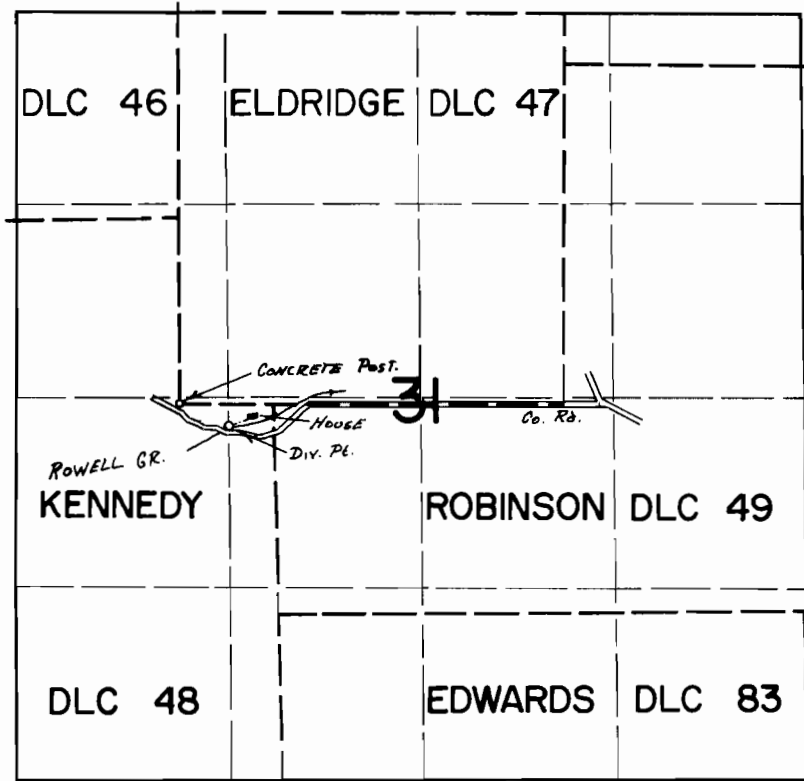

*Div. Pl. Loc. 150'S & 340'E FROM SW COR ELDRIDGE DLC 47*

**FINAL PROOF SURVEY**  
UNDER

Application No. 47974... Permit No. 35986...  
IN NAME OF

..... GENE FISHER .....

Surveyed April 22 1974, by J. J. PAUL.....