


T.6S. R.6W. W.M.

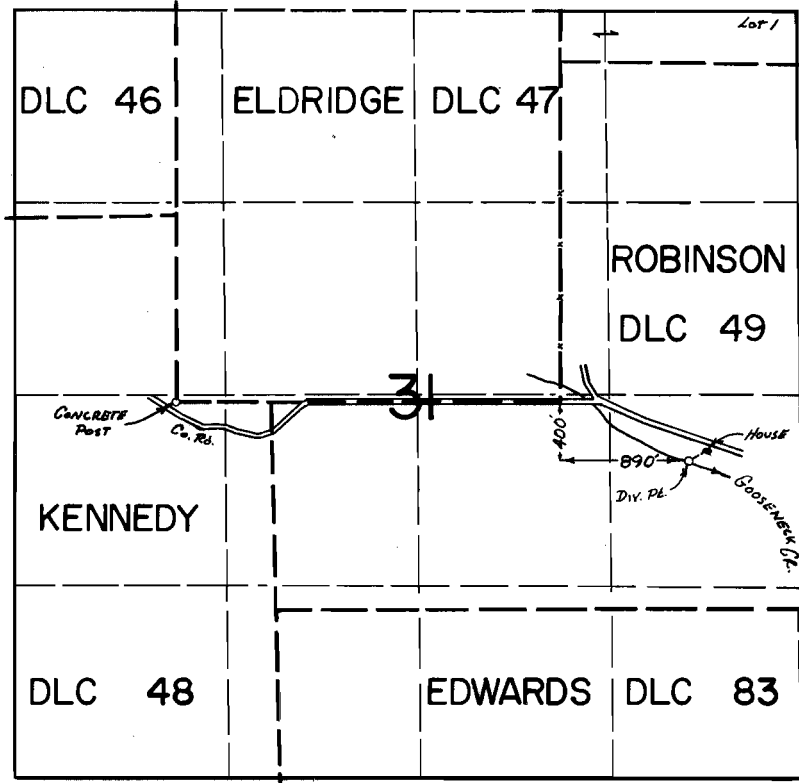

FINAL PROOF SURVEY
UNDER

Application No. 48372... Permit No. 36317....
IN NAME OF

..... ROBERT J. BAUER

Surveyed April 22 1974, by T. J. PAUL.....