


T.8S. R.6W. W.M.

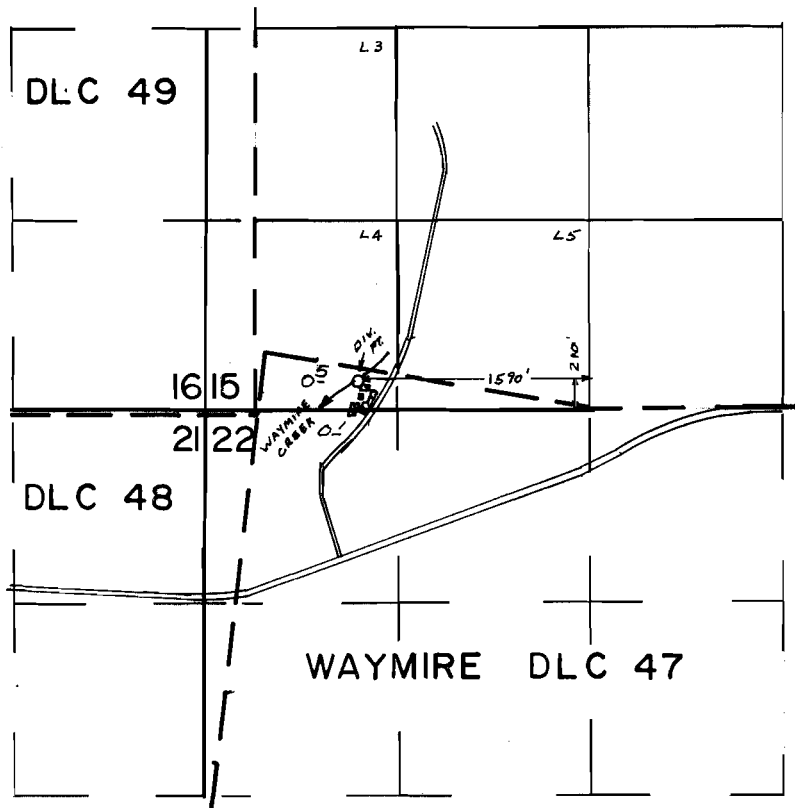

FINAL PROOF SURVEY UNDER

Application No. 48436... Permit No. 36358...
IN NAME OF

STANLEY R. & DIANE M. DOWNS...

Surveyed JUL 15... 1974, by L.H. NUNN.....