


6-4672  
43083

T.5N.R.35E.W.M.

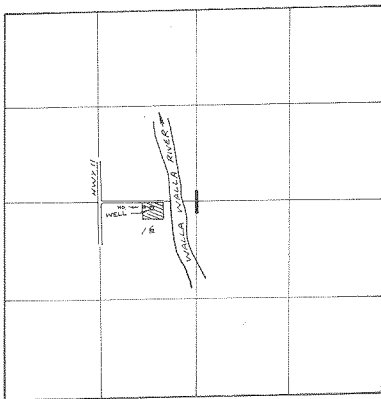

WELL LOC: 80'S. & 720'E. FROM NW COR. NE 4 SW 4 SEC 1

FINAL PROOF SURVEY  
UNDER

Application No. G-4950. Permit No. G-4672  
IN NAME OF

ROY W. & MARY L. HAMBLER

Surveyed APR. 16, 1973, by R. MURKIN