


T.4S.,R.38&4W., W.M.

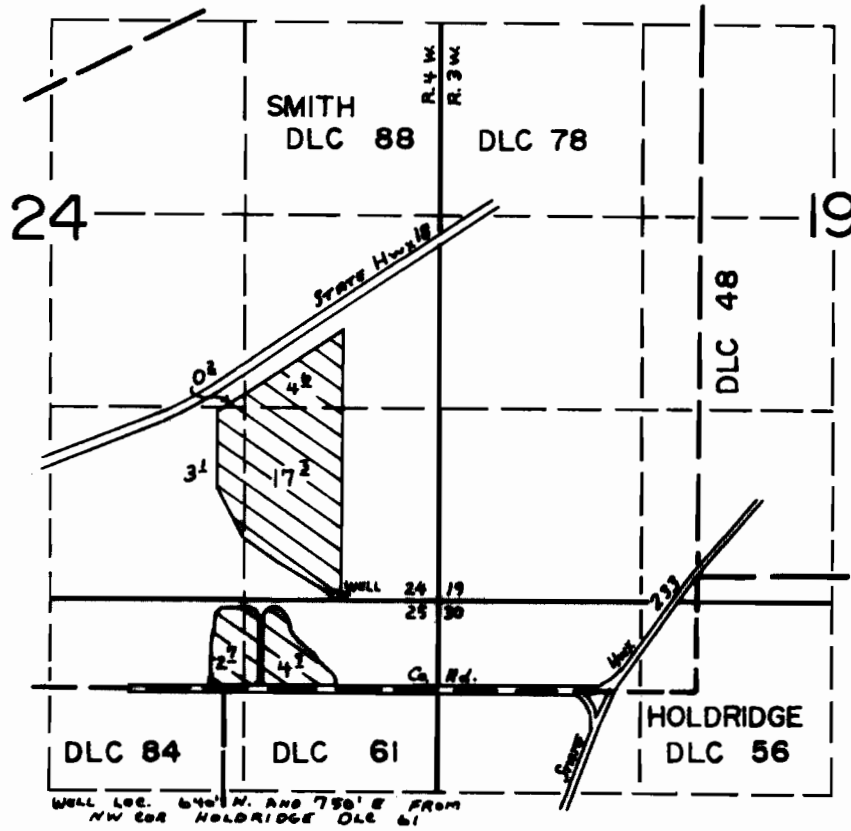

FINAL PROOF SURVEY
UNDER

Application No. G-4977 Permit No. G-4665
IN NAME OF

IRVIN J. & EVELYN L. TEEGARDEN

Surveyed May 17 1973, by D. Nohay
June 12 1974 L. TOLL