


T.5S. R.6&7W. W.M.

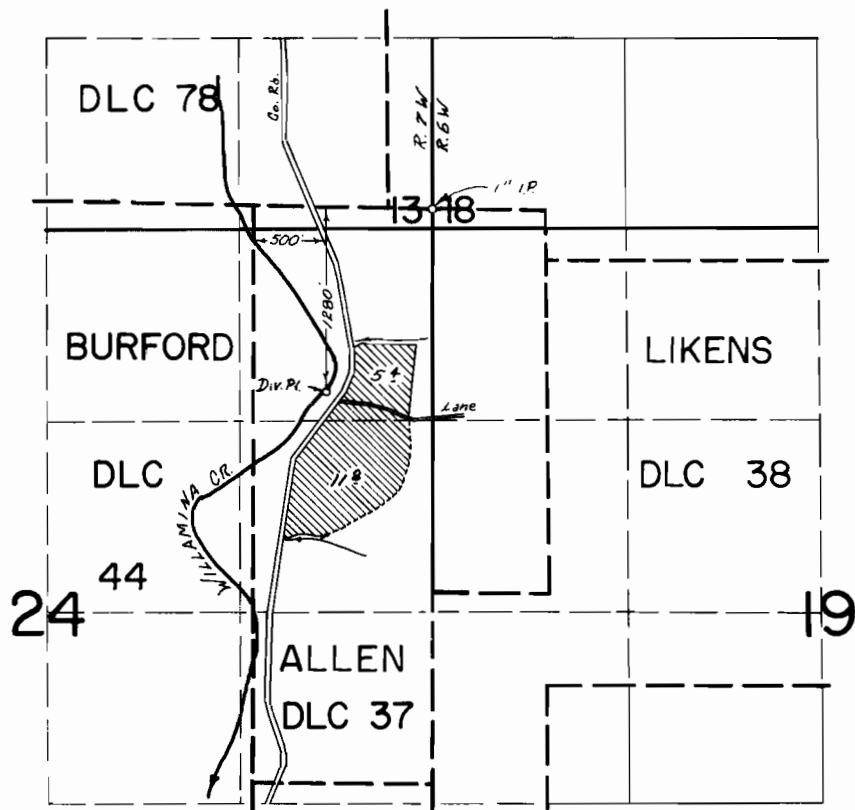

FINAL PROOF SURVEY
UNDER

Application No. 39419... Permit No. 29387...
IN NAME OF

ROYCE S. PROSSER

Surveyed OCT. 9. 1974, by T. J. PAUL