


T.4 S. R.5 W. W.M.

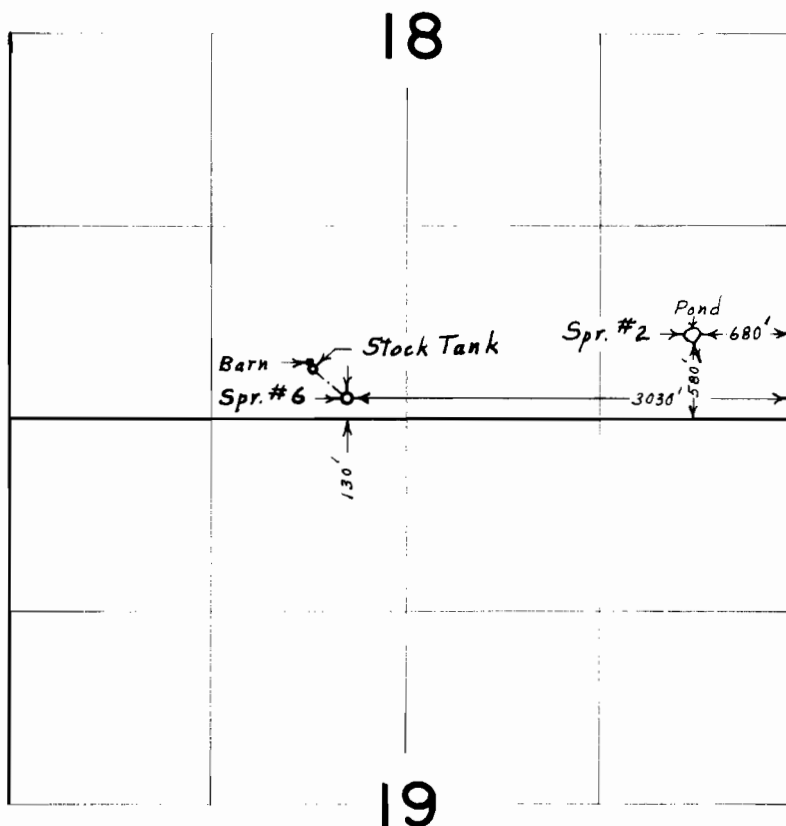

FINAL PROOF SURVEY
UNDER

Application No. 46028 Permit No. 34255
IN NAME OF

D. L. STEVENS

Surveyed Sept. 27, 1974, by L. E. Gould