


T. 2 S. R. 3 & 4 W. W.M.

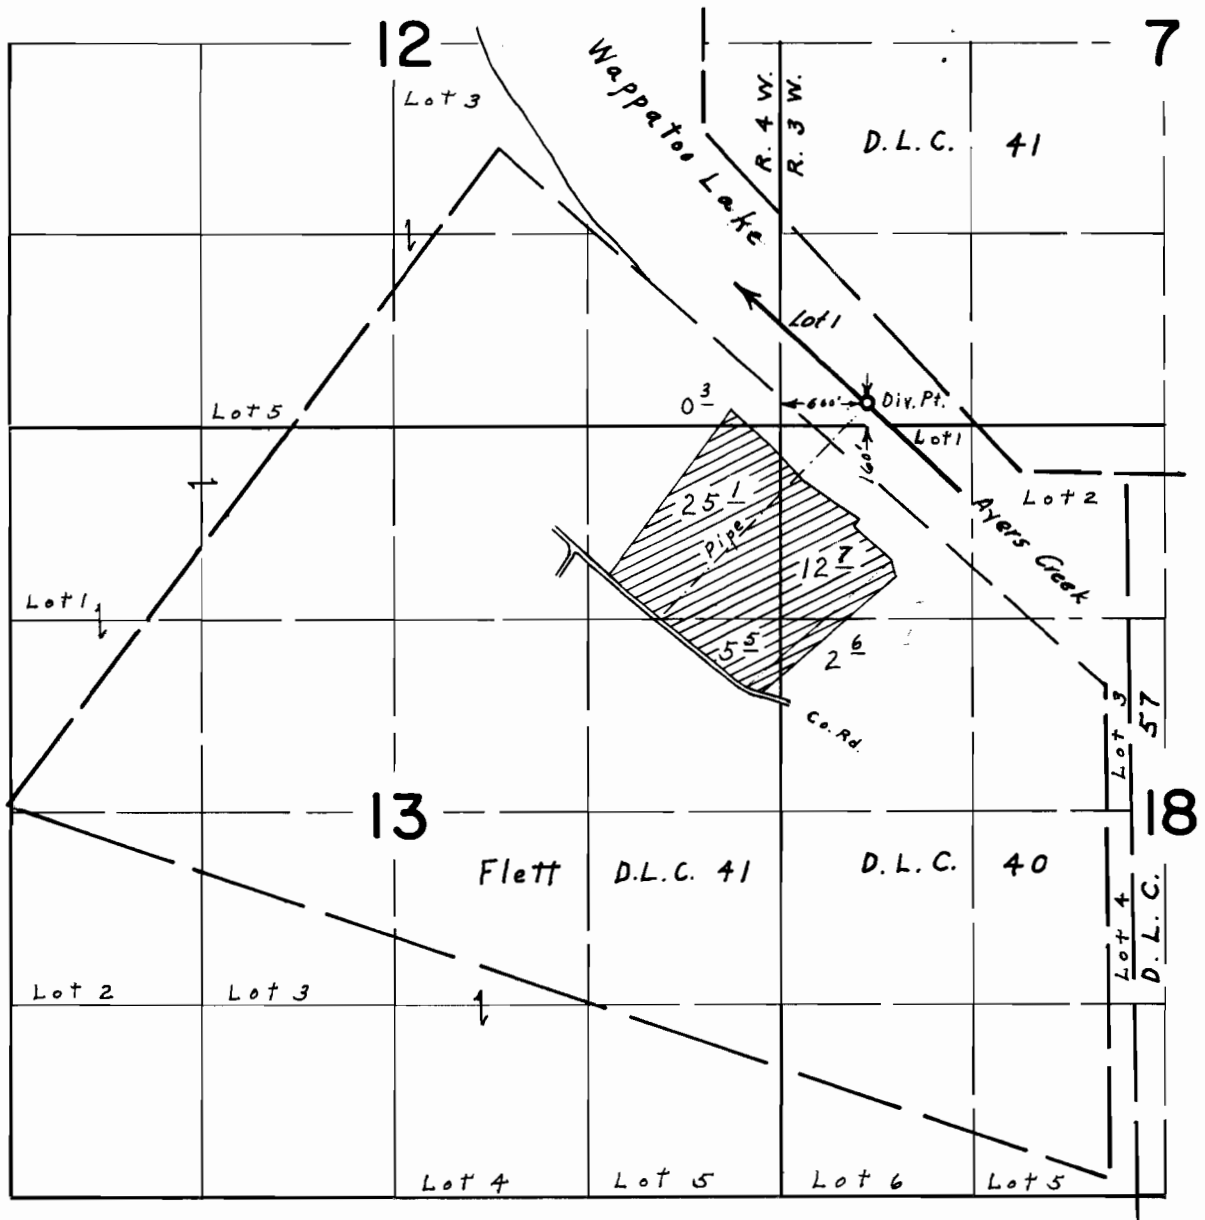

FINAL PROOF SURVEY
UNDER

Application No. 47470 Permit No. 35559
IN NAME OF

GEORGE & EDNA WOELL

Surveyed May 28 1974, by L. E. Gould