


# T. 4S. R. 3W. W.M.

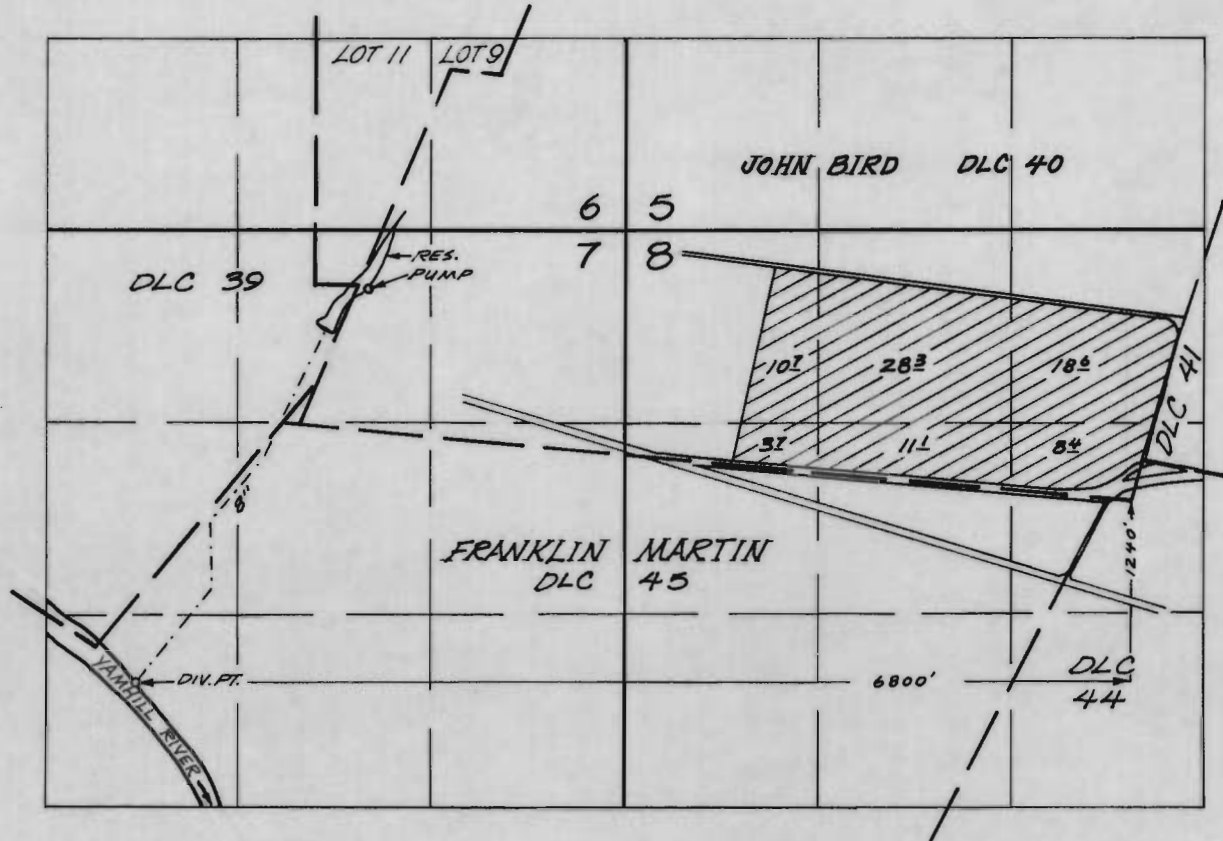

## FINAL PROOF SURVEY UNDER

Application No. 48106 Permit No. 36125  
IN NAME OF

STANLEY K. BANSEN

Surveyed JULY 24 1974, by L.M.TOLL