


T.4S.,R.4W.,W.M.

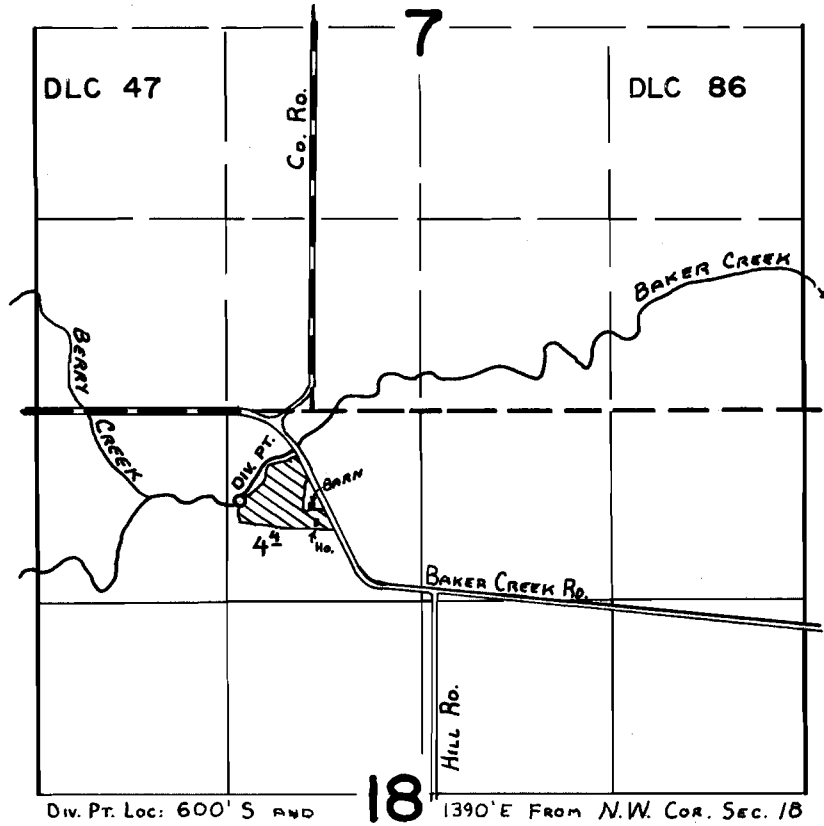

FINAL PROOF SURVEY UNDER

Application No. 48236 Permit No. 36224
IN NAME OF

THOMAS EDWARD DRAPER

Surveyed JULY 25 1974, by L. TOLL