


# T.4S. R.4&5W. W.M.

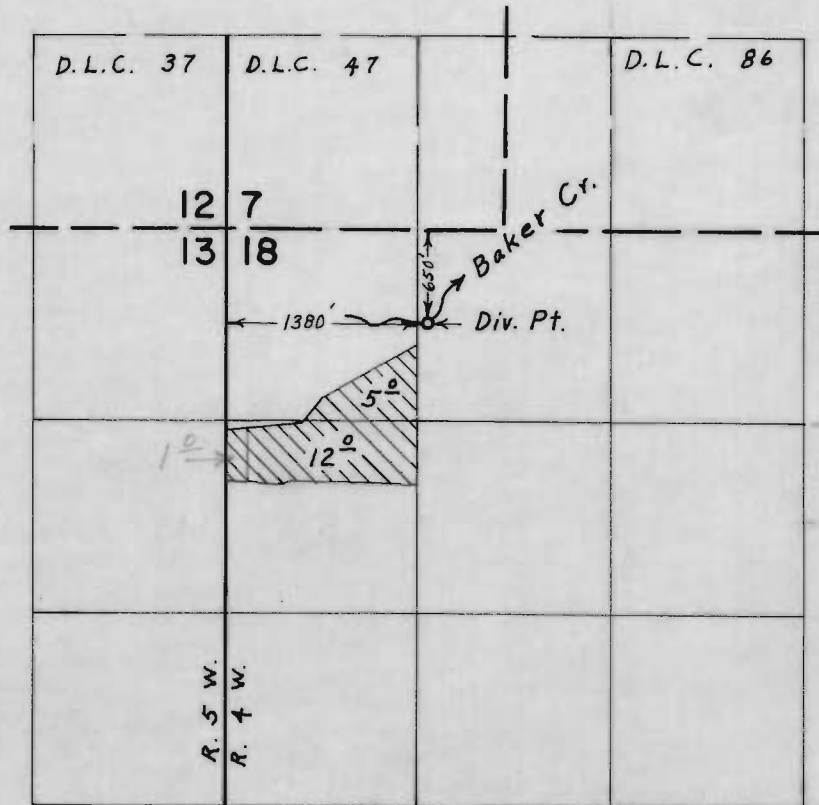

## FINAL PROOF SURVEY UNDER

Application No. 50891 Permit No. 36960  
IN NAME OF

THOMAS EDWARD DRAPER

Surveyed Sept. 25, 1974, by L. E. Gould