


T. 5 S. R. 6 W. W.M.

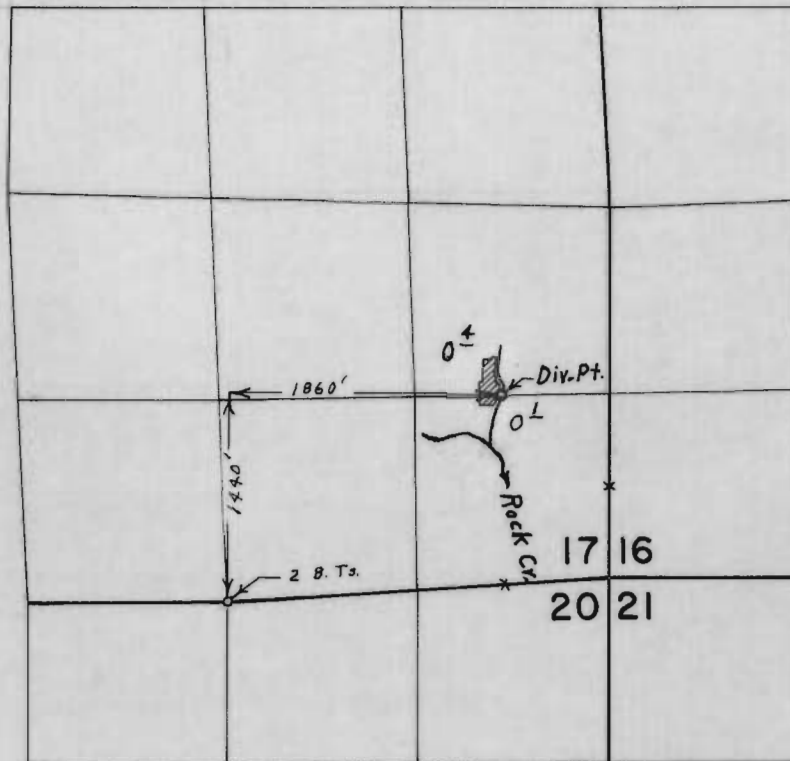


**FINAL PROOF SURVEY**  
UNDER

Application No. 49460 Permit No. 37049  
IN NAME OF

**NOAH A. WRIGHT**

Surveyed May 1, 1974, by L.E. Gould

T.5 S. R.6 W. W.M.

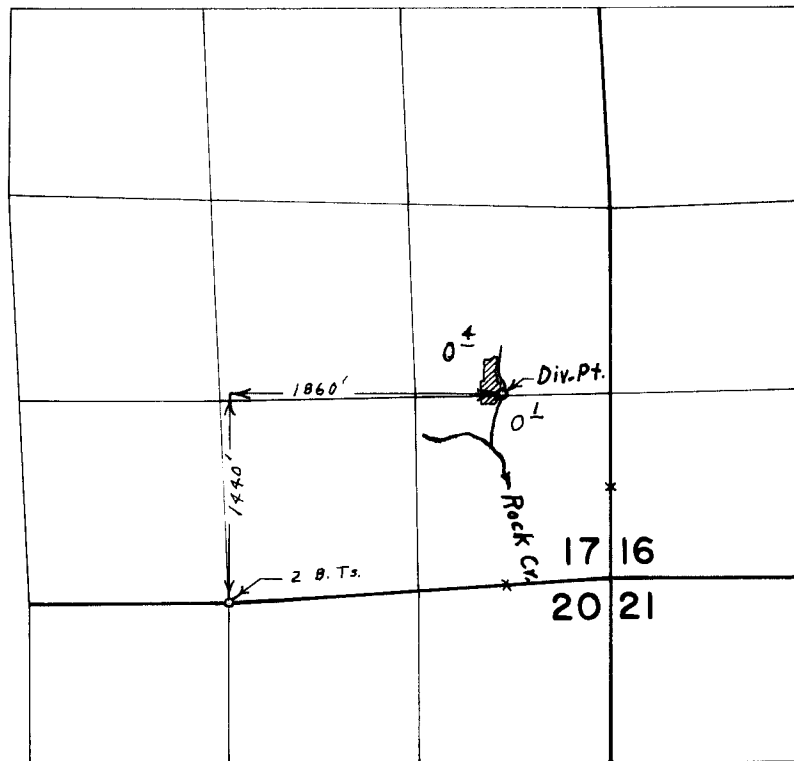

**FINAL PROOF SURVEY**  
UNDER

Application No. 49460 Permit No. 37049  
IN NAME OF

NOAH A. WRIGHT

Surveyed May 1, 1974, by L.E. Gould