


T.4 S., R.3 W., W.M.

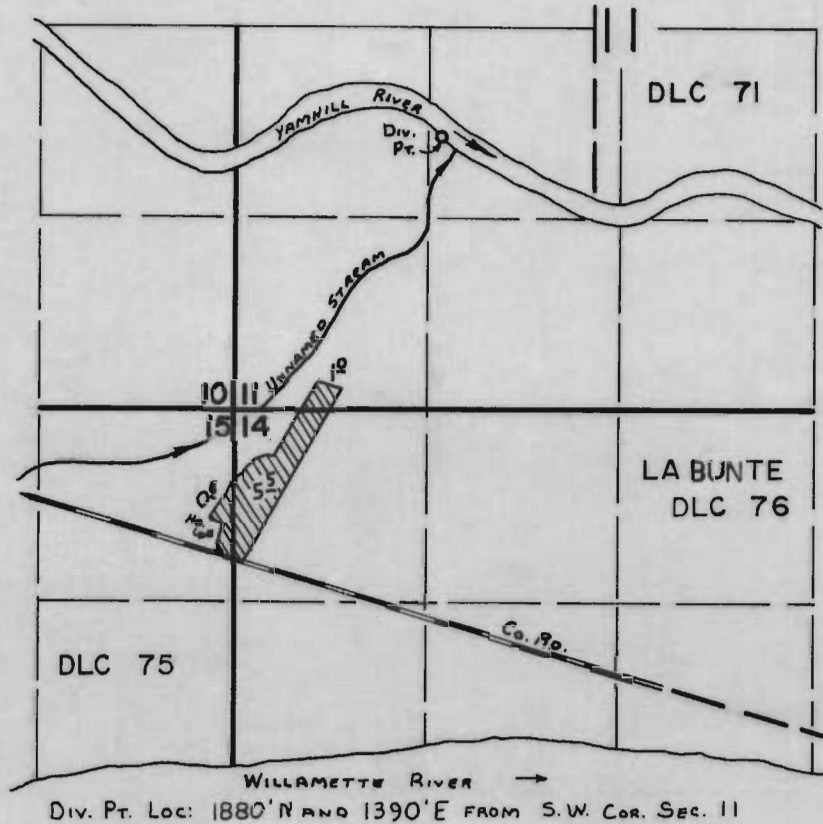

**FINAL PROOF SURVEY**  
UNDER

Transfer No. **2676**  
Application No. **49472** Permit No. **37058**  
IN NAME OF

**WILLIS PITKIN**

Surveyed JUNE 14 1974, by L. TOLL