T.5S. R.7W. W.M.

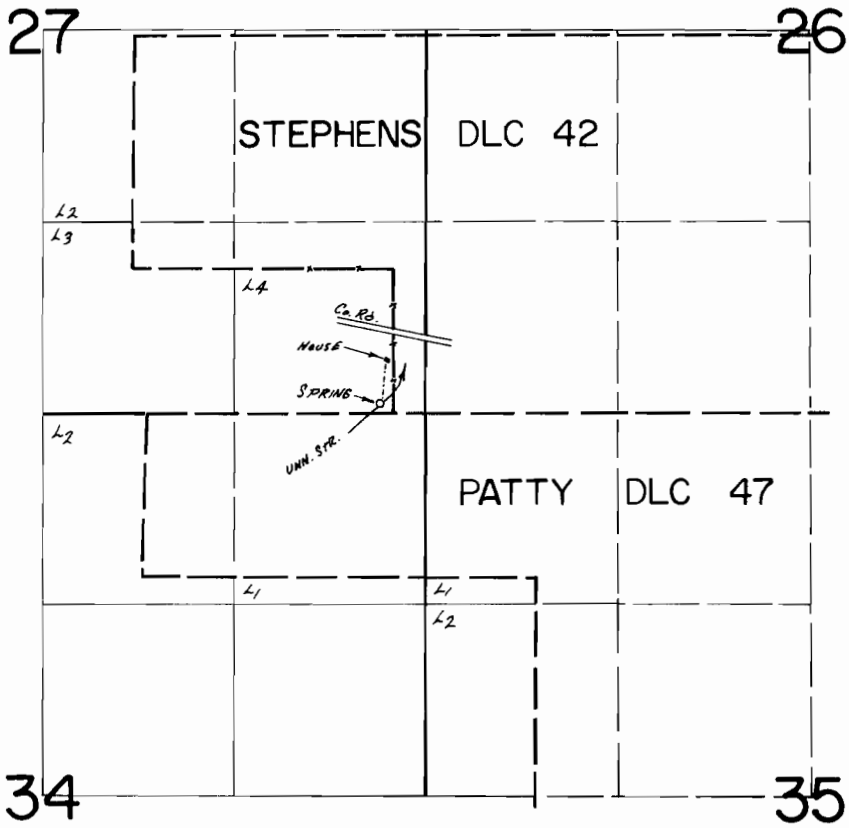

SPRING LOC: 930' S & 90' W FROM NE COR LOT 4 SEC 27

FINAL PROOF SURVEY
UNDER

Application No. 49677 Permit No. 37193
IN NAME OF

CHESTER W. NEWBERG

Surveyed OCT. 9 1974, by T. J. PAUL

1974H