


T. 6 S. R. 2 E. W. M.

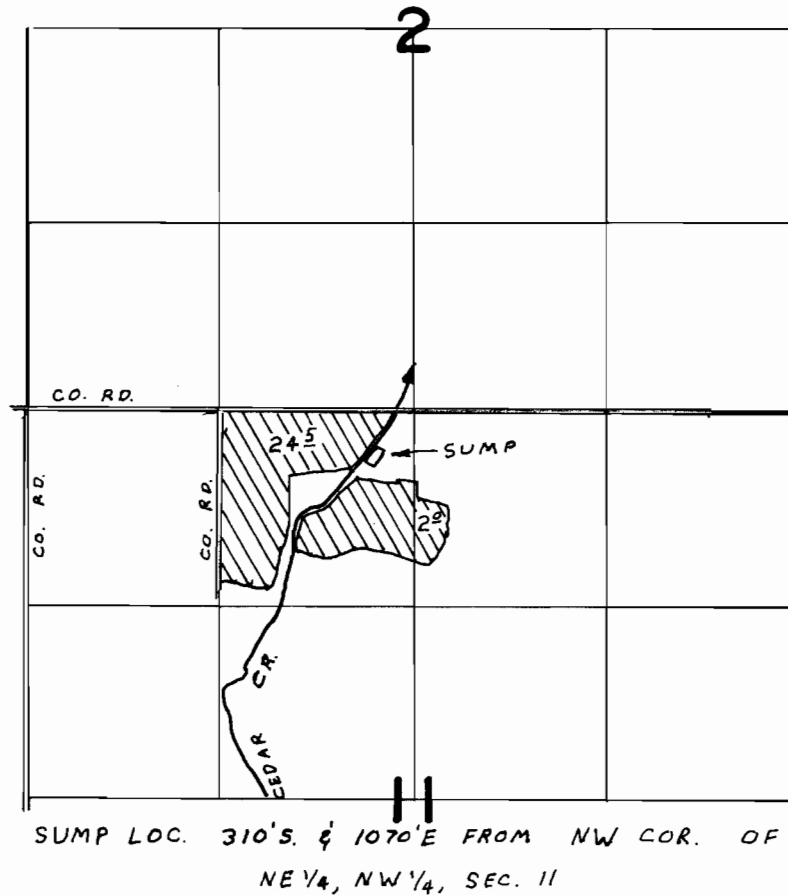

FINAL PROOF SURVEY
UNDER

Application No. G-3522 Permit No. G-3314
IN NAME OF

CARL T. NOVAK

Surveyed NOV. 7, 1974, by L.H. NUNN