


T.4S, R.1W-1E, W.M.

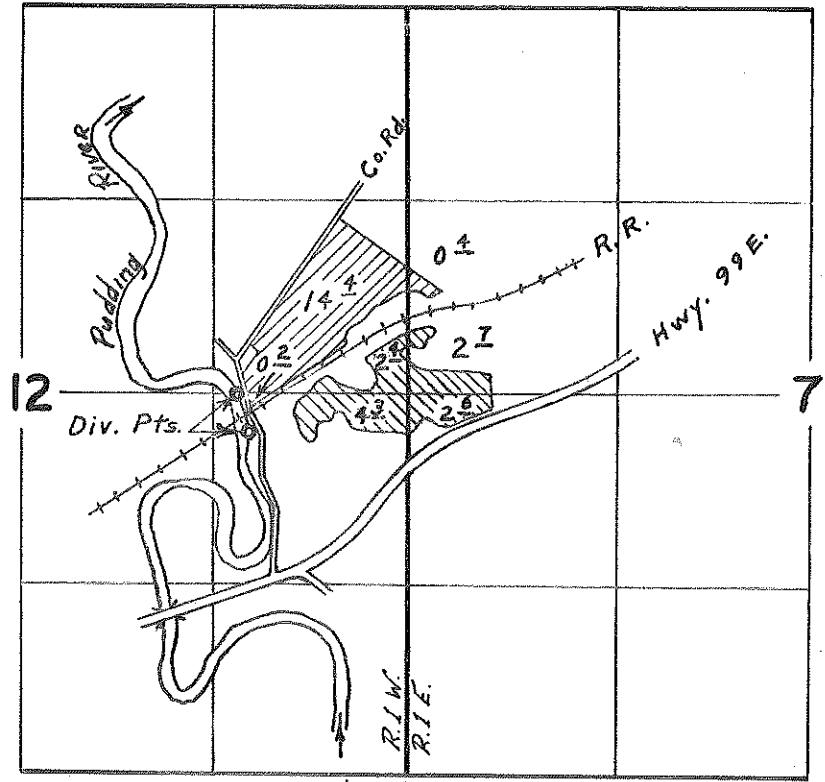

Div. Pts. located: 2600' N. & 1100' W.; 2340' N. & 1100' W. from S.E. Cor. Sec. 12

Tanner 

Ramboz 

FINAL PROOF SURVEY UNDER

Application No. 40401 Permit No. 30126 IN NAME OF

EVERETT RAMBOZ

Surveyed July 30, 1973, by D. NOREY
May 8, 1975 L. E. Gould