


T. 3 S. R. 1 E. W. M.

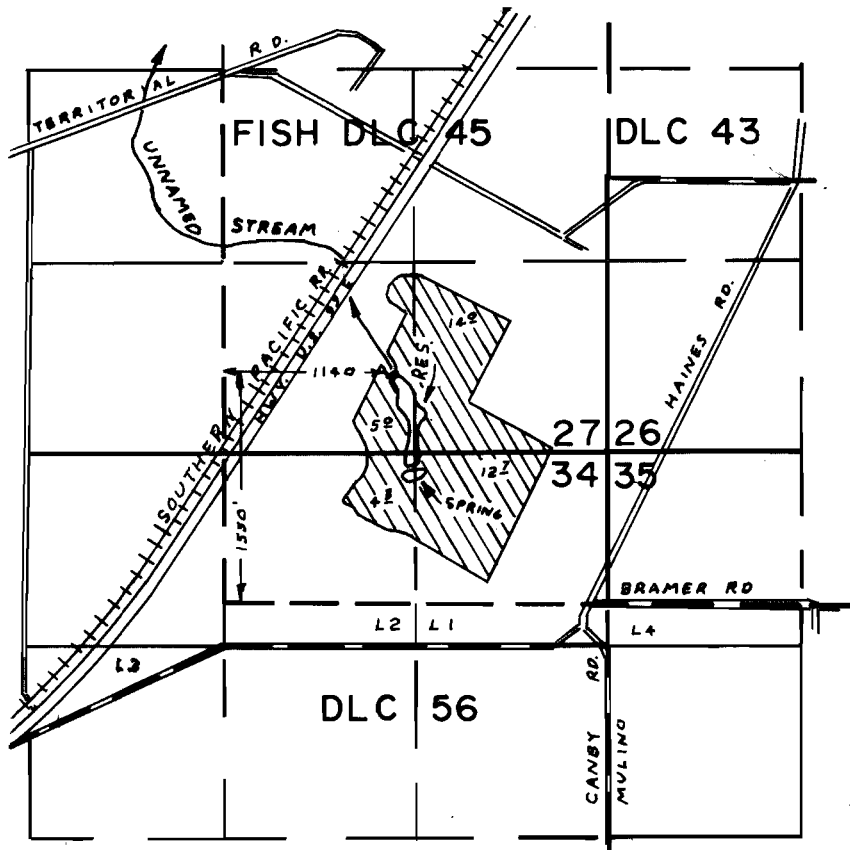

FINAL PROOF SURVEY UNDER

R-44367 R-5098
Application No. 44368 Permit No. 32980
IN NAME OF

HAROLD E. SCHWEITZER

Surveyed OCT. 7 1974, by L.H. NUNN