


T.4 S. R.3 & 4 E. W.M.

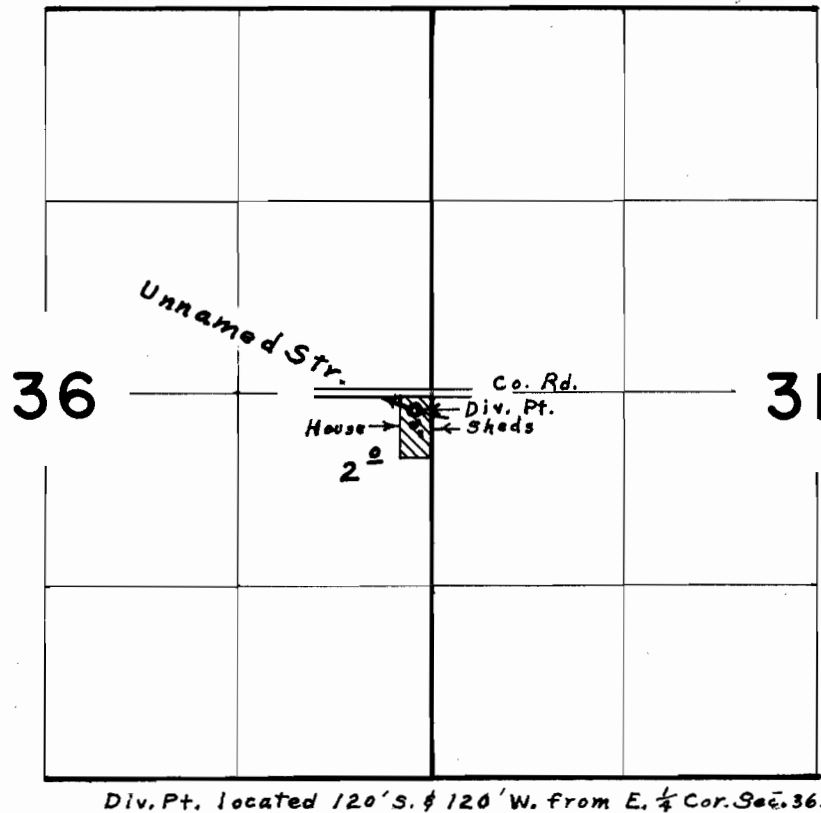

Div. Pt. located 120' S. & 120' W. from E. $\frac{1}{4}$ Cor. Sec. 36.

FINAL PROOF SURVEY

UNDER

Application No. ~~44603~~ Permit No. 33381

IN NAME OF
JAMES W. GOIN

Surveyed May 30, 1975, by L. E. Gould