


T. 2 S. R. 2 E. W.M.

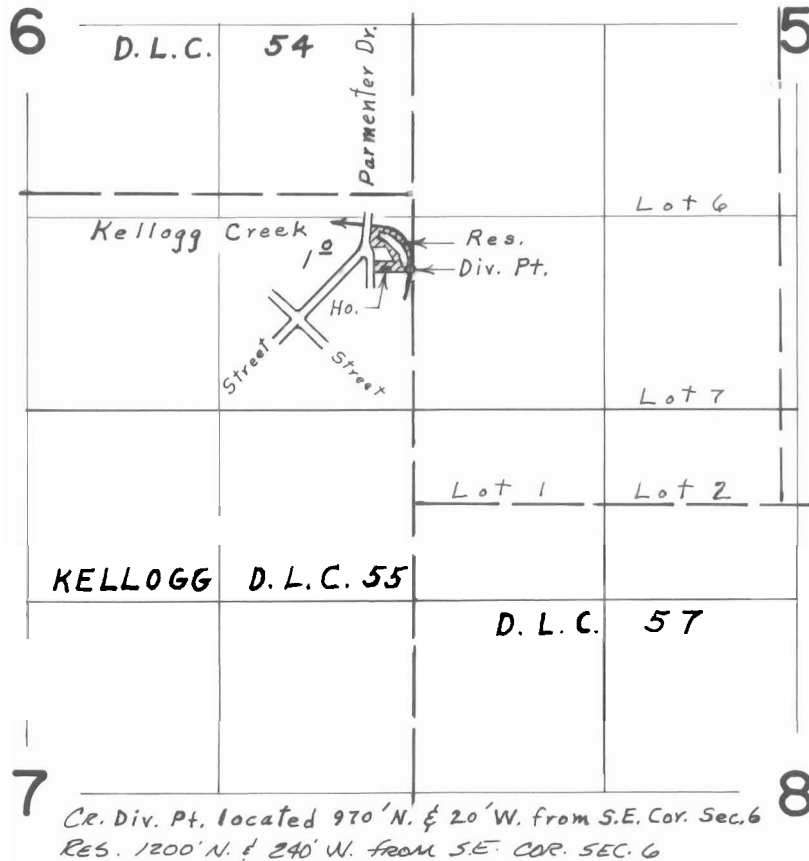

FINAL PROOF SURVEY UNDER

R-46800 R-5595
 Application No. 40801 Permit No. 34943
 IN NAME OF

HERBERT A. & MARGARET L. MANNING

Surveyed Oct. 2, 1975, by L. E. Gould