


T. 3 S. R. 5 E. W.M.

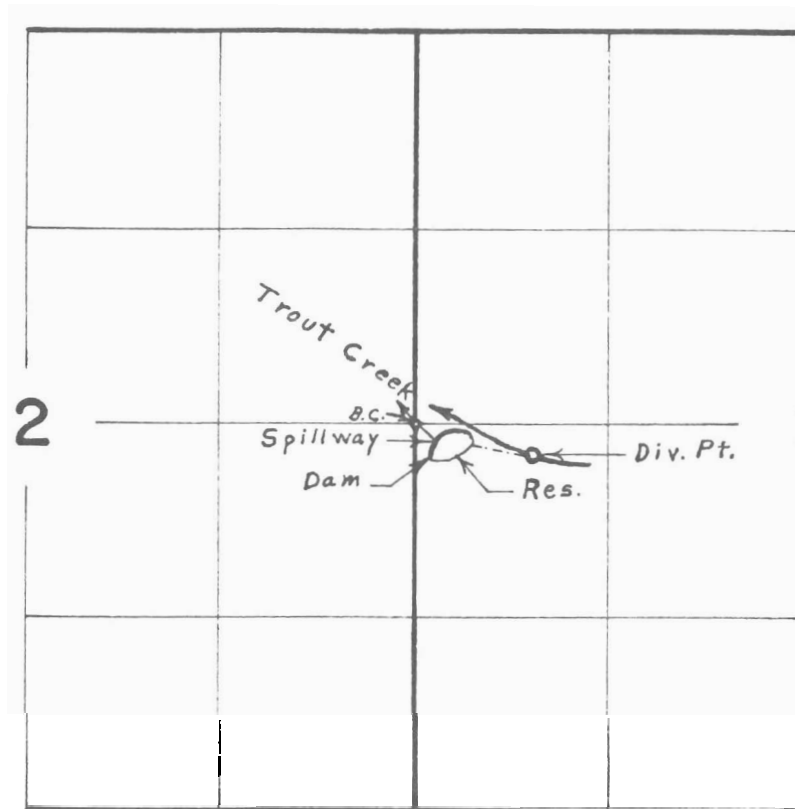

CR. Div. Pt. located 210' S. & 820' E. from W. $\frac{1}{4}$ Cor. Sec. 1
RES. 110' S. & 120' E. from W. $\frac{1}{4}$ Cor. Sec. 1

INAL PROOF SURVEY

R-46426
46491

R-5531
34718

E. T. CORNWELL

Aug. 25, 75 L. E. Gould