


T. 3 S. R. 5 E. W.M.

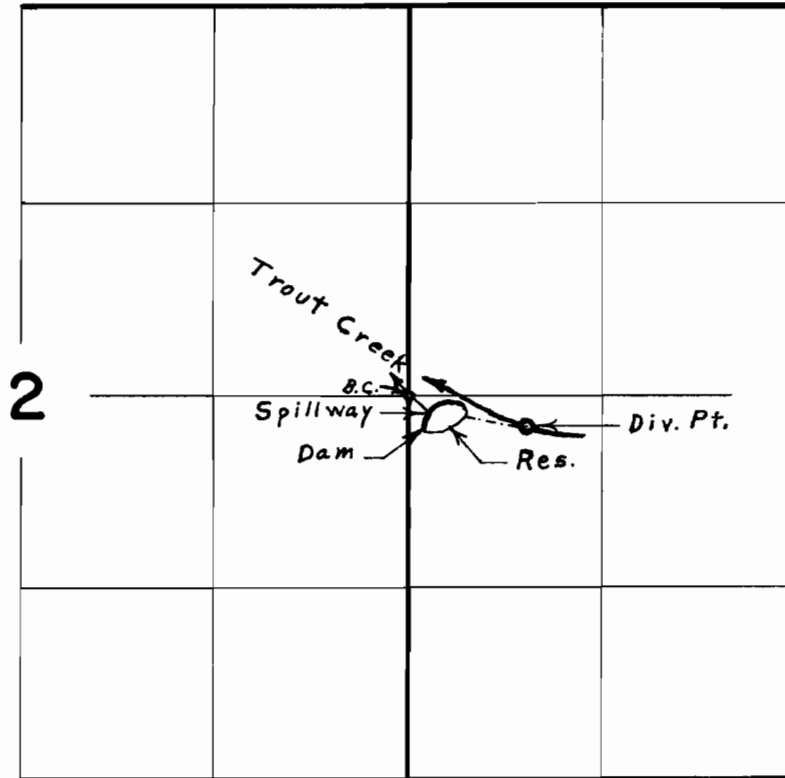

CR. Div. Pt. located 210'S. & 820'E. from W. $\frac{1}{4}$ Cor. Sec. 1
RES. 110'S. & 120'E. from W $\frac{1}{4}$ Cor. SEC. 1

FINAL PROOF SURVEY

UNDER

Application No. R-46426 46426 Permit No. R-5531 34718

IN NAME OF

E. T. CORNWELL

Surveyed Aug. 25, 1975, by L. E. Gould