


T.4S., R.2E., W.M.

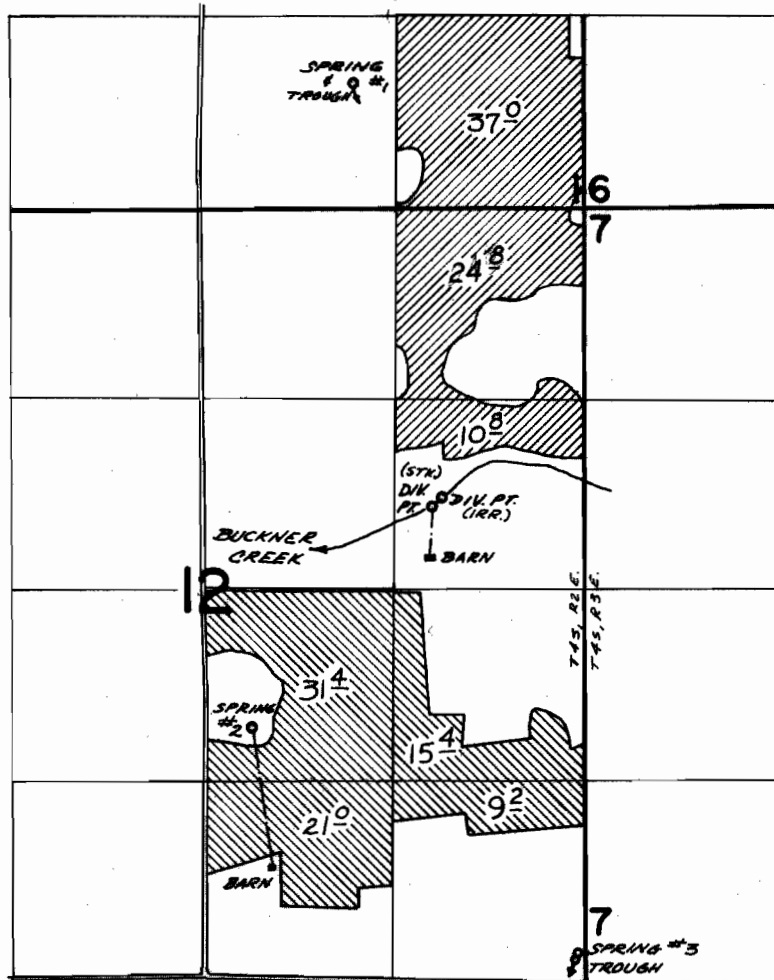

SPRINGS LOCATED: 1- 3480' N & 1050' E;
 2- 950' S & 310' E;
 3- 2510' S & 2560' E;
 DIV. PTS. LOCATED: STK.- 560' N & 1570' E;
 IRR.- 610' N & 1640' E;
 ALL FROM CENTER SEC. 12.

FINAL PROOF SURVEY UNDER

47020 34919
 Application No. 45060 Permit No. 33673
 IN NAME OF

SCHMIDT BROS. FARMS

Surveyed Sept. 5 1974, by *D. Dorby*