


T.2S. R.5E. W.M.

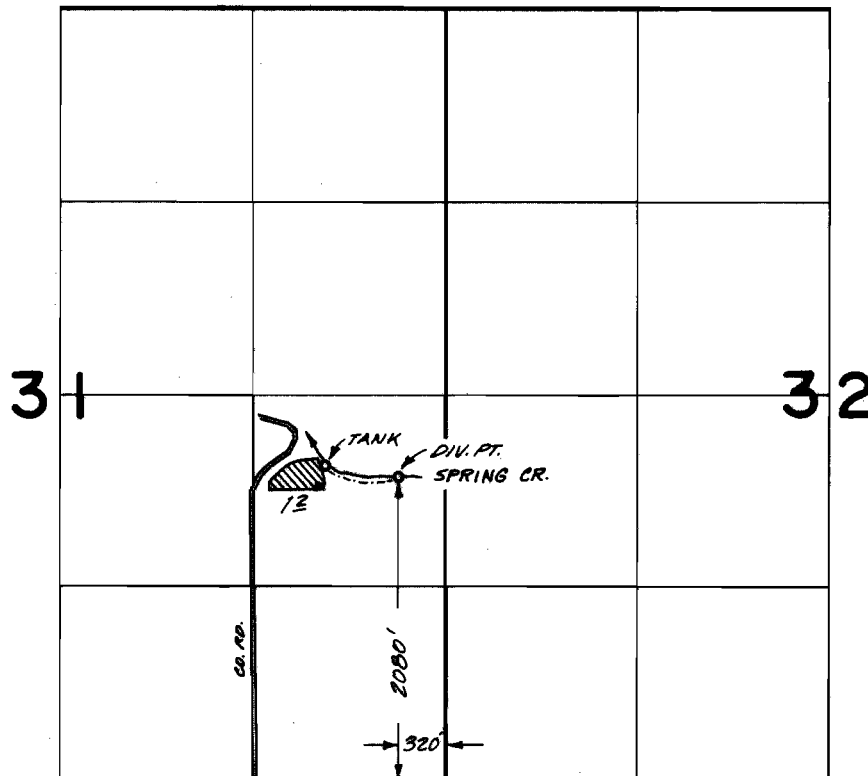

FINAL PROOF SURVEY
UNDER

Application No. 46976 Permit No. 35146
IN NAME OF

GEORGE F. DOBIN

Surveyed SEPT. 24 1975, by R.G. MUCKEN