


T.3 S. R.5 E. W.M.

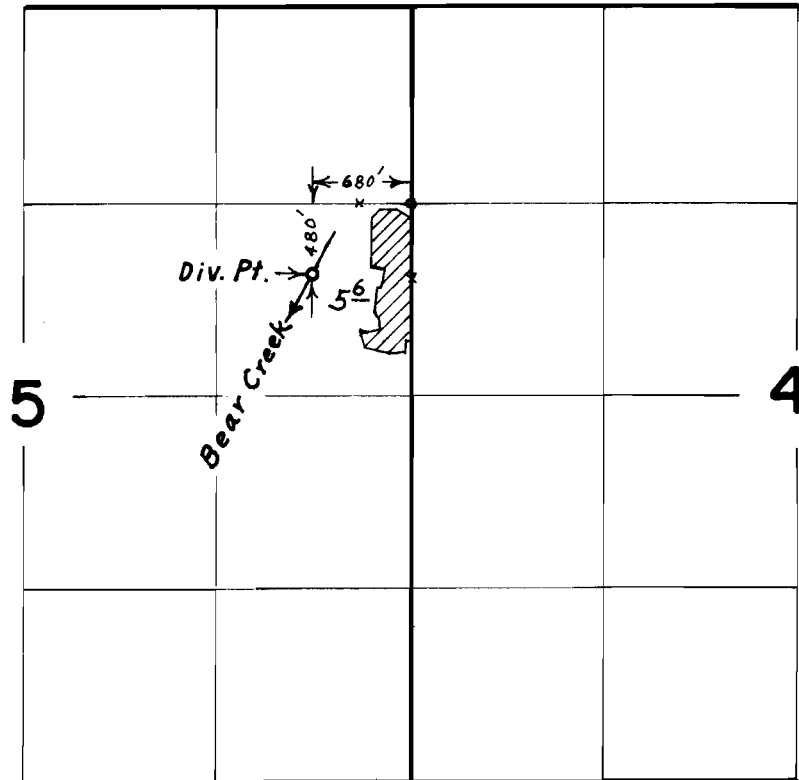

FINAL PROOF SURVEY

UNDER

Application No. 47242 Permit No. 35385

IN NAME OF

HAROLD REED JOHNSTON

Surveyed Aug. 26 1975, by L. E. Gould