


T.3 & 4 S. R.5 E. W.M.

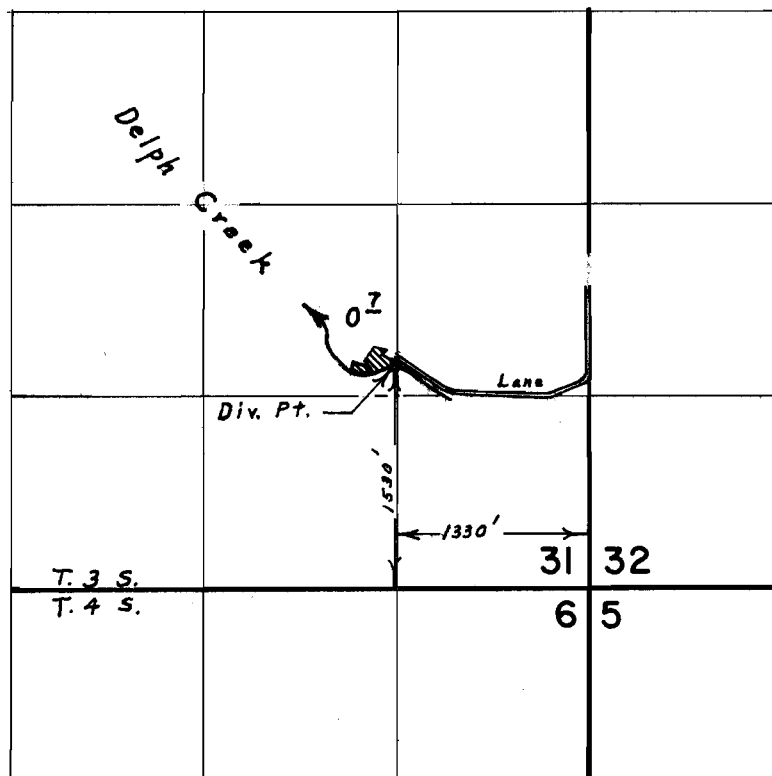

FINAL PROOF SURVEY

UNDER

Application No. 48222 Permit No. 36214

IN NAME OF

LOREN B. BOWMAN

Surveyed Aug. 28 1975, by L. E. Gould