


T. 2S. R. 5E. W.M.

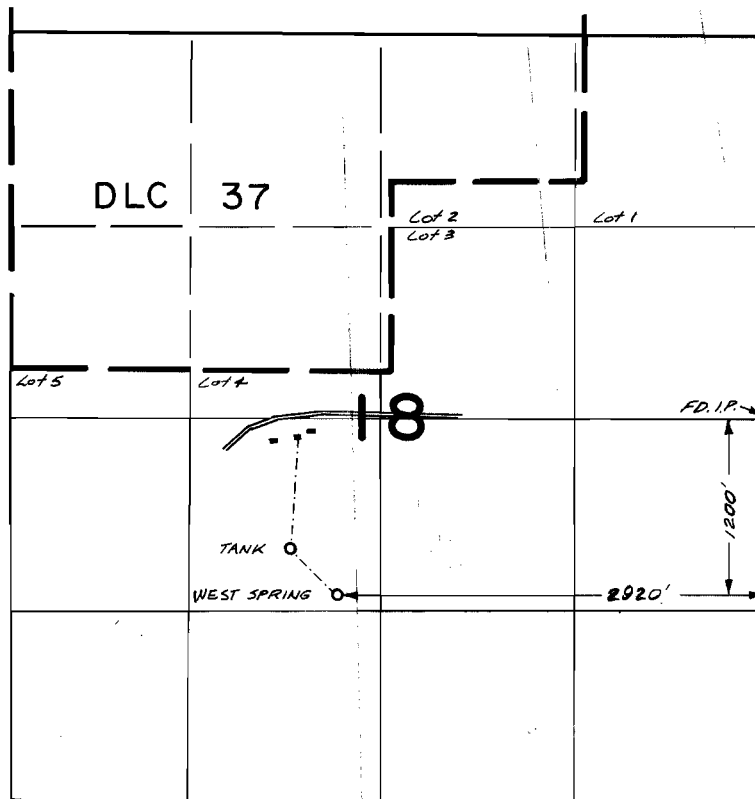

FINAL PROOF SURVEY
UNDER

Application No. 48272 Permit No. 36256
IN NAME OF

JAY CARROL HOYT

Surveyed SEPT 23 1975, by R. G. MUCKEN