


T.4S., R.1W. & IE., W.M.

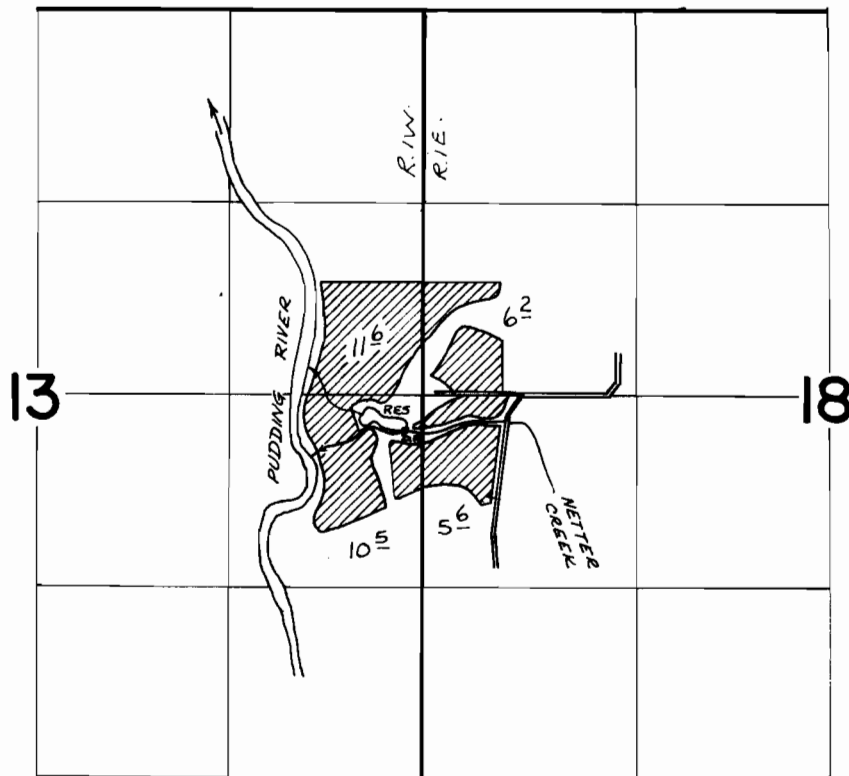

DIV. PT. LOC.: CR. - 2400' N & 110' W FROM SE COR. SEC. 13.
RES. - 2500' N & 410' W FROM SE COR. SEC. 13.

FINAL PROOF SURVEY
UNDER

R-48754

R-5915

Application No. 48755 Permit No. 36567

IN NAME OF

GREG CORREY

Surveyed Sept. 17 1974, by [Signature]