


T.4S., R.1W. & IE., W.M.

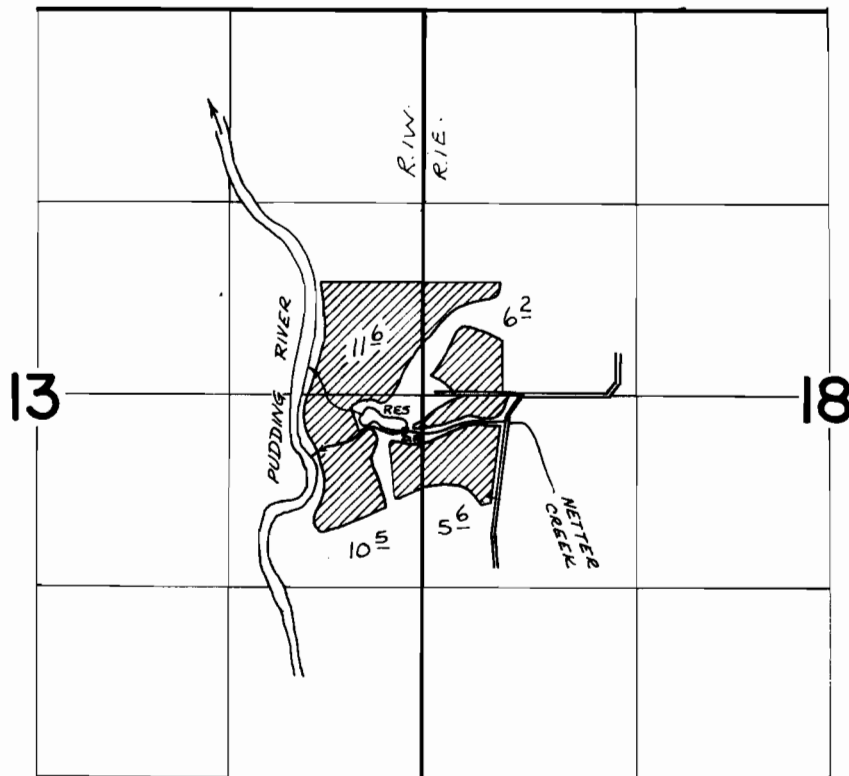

DIV. PT. LOC.: CR. - 2400' N & 110' W FROM SE COR. SEC. 13.
RES. - 2500' N & 410' W FROM SE COR. SEC. 13.

FINAL PROOF SURVEY
UNDER

R-48754

R-5915

Application No. **48755**. Permit No. **36567**

IN NAME OF

GREG CORREY

Surveyed **Sept. 17** 1974, by *J. Norby*